

**CORRECTION(S) TO WATER WELL RECORD (WWC-5)**

(to rectify lacking or incorrect information)

County: Wyandotte

Location listed as:

Location changed to:

Section-Township-Range: 2-115-25E

2-115-25E

Fraction (  $\frac{1}{4}$   $\frac{1}{4}$   $\frac{1}{4}$ ): NW NE NW

W2 E2 NE NW

Other changes: Initial statements: \_\_\_\_\_

Changed to: \_\_\_\_\_

Comments: \_\_\_\_\_

verification method: Map of well locations from owner, and

North Kansas City 1:24,000 topo. map.

initials: DRd date: 9/15/2005

submitted by: Kansas Geological Survey, Data Resources Library, 1930 Constant Ave., Lawrence, KS 66047-3726

to: Kansas Dept of Health & Environment, Bureau of Water, 1000 SW Jackson, Suite 420, Topeka, KS 66612-1367.

[illegible]



<b>PROJECT NUMBER</b> 321564.SI.01	<b>BORING NUMBER</b> MW-304D
SHEET 1 OF 2	
<b>SOIL BORING LOG</b>	

PROJECT : Conoco Phillips - Supplemental SI ELEVATION : 749.71 ft b.t.o.c. DRILLING METHOD AND EQUIPMENT USED CME 750 WATER LEVELS : 32.0' bgs during drilling	NORTHING: 306907.49    EASTING: 2275233.33 DRILLING CONTRACTOR : Max's Enterprises Inc. LOGGER : C. Morris START : 11/03/04 0840    END : 11/04/04 0830
---	---


DEPTH BELOW SURFACE (FT)	INTERVAL (FT)	RECOVERY (FT)	#/TYPE	STANDARD PENETRATION TEST RESULTS 6"-6"-6" (N)	SOIL DESCRIPTION	COMMENTS
					SOIL NAME, USCS GROUP SYMBOL, COLOR, MOISTURE CONTENT, RELATIVE DENSITY, OR CONSISTENCY, SOIL STRUCTURE, MINERALOGY.	DEPTH OF CASING, DRILLING RATE, DRILLING FLUID LOSS, TESTS, AND INSTRUMENTATION.
						Notes
5	No Soil Sampling				0.0': Silty sand (SM), light tan to brown, moist, loose, fine to coarse, stained  2.0': Dark brown, some stained black chunks of fill/asphalt material  4.0': Well graded sand (SW), tan with rust colored staining, moist, fine to medium 5.0': Silty sand (SM), rusty brown with gray and black staining, moist, strong HC odor, trace black fill 6.0': Poorly graded sand (SP), brown, moist, fine to coarse, HC odor, some black staining  7.5': Sandy silt (ML), dark brown to black, moist, visible free product, sheen, iridescence 9.0': Silty clay with sand (CL), black, slight moist, soft, medium plasticity, HC odor  11.0': Slight sheen visible, trace fine gravel  13.0': Elastic silt (MH), dark gray, wet, soft, plastic, product-sheen squeezes to surface, strong HC odor  15.0': Increasing fine sand, product 16.0': Sandy silt (ML), dark gray to black, moist, fine 17.0': Silty sand (SM), black, moist, fine, HC odor  20.0': Sheen 21.0': Silty sand (SM), black, moist, loose, strong odor, no sheen  23.0': Poorly graded sand (SP), dark gray, moist, fine to medium, strong HC/creasote-like odor	
10						
15						
20						
25						




PROJECT NUMBER 321564.SI.01	BORING NUMBER MW-304D
SHEET 2 OF 2	
<b>SOIL BORING LOG</b>	

PROJECT : Conoco Phillips - Supplemental SI	NORTHING: 306907.49    EASTING: 2275233.33
ELEVATION : 749.71 ft b.t.o.c.	DRILLING CONTRACTOR : Max's Enterprises Inc.
DRILLING METHOD AND EQUIPMENT USED CME 750	LOGGER : C. Morris
WATER LEVELS : 32.0' bgs during drilling	START : 11/03/04 0840    END : 11/04/04 0830

DEPTH BELOW SURFACE (FT)	INTERVAL (FT)	RECOVERY (FT)	#/TYPE	STANDARD PENETRATION TEST RESULTS 6"-6'-6" (N)	SOIL DESCRIPTION SOIL NAME, USCS GROUP SYMBOL, COLOR, MOISTURE CONTENT, RELATIVE DENSITY, OR CONSISTENCY, SOIL STRUCTURE, MINERALOGY.	COMMENTS DEPTH OF CASING, DRILLING RATE, DRILLING FLUID LOSS, TESTS, AND INSTRUMENTATION.
						Notes
					30.0': Poorly graded sand with trace silt (SP), olive gray, increasing moisture content, strong odor	
					34.0': Approx water table	
35					35.0': Silty sand (SM), dark gray, wet to saturated, poorly sorted, strong odor and sheen/NAPL indication	
					37.0': Increasing product, oily appearance	
40						
					48.0': Silty sand (SM), dark olive gray, wet to saturated, grading to some medium sand and trace fine gravel, sheen, oily appearance, strong odor	
50						
					52.0': Well graded sand with gravel (SW), dark olive gray, saturated (flowing sand?), fine to coarse, sheen, strong odor	
55						
					55.0': Well graded sand with gravel (SW), dark gray, wet to saturated, strong odor	

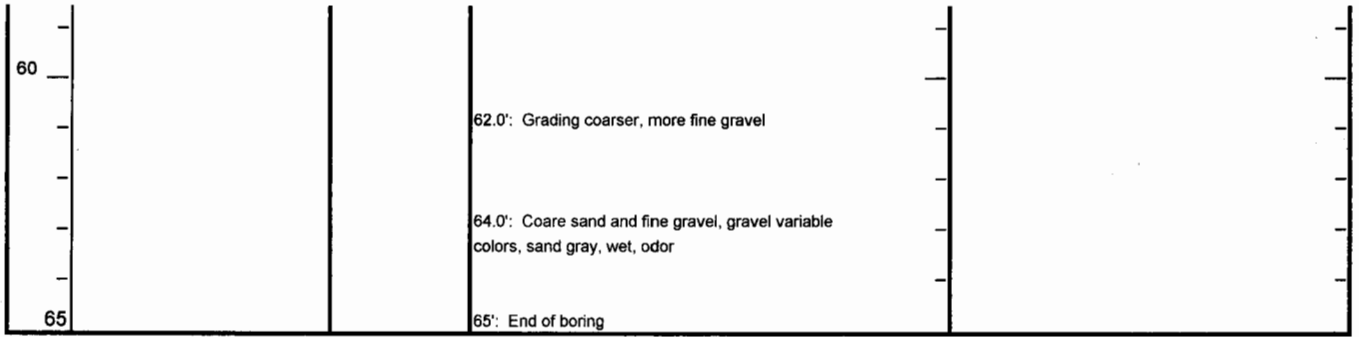

R25E

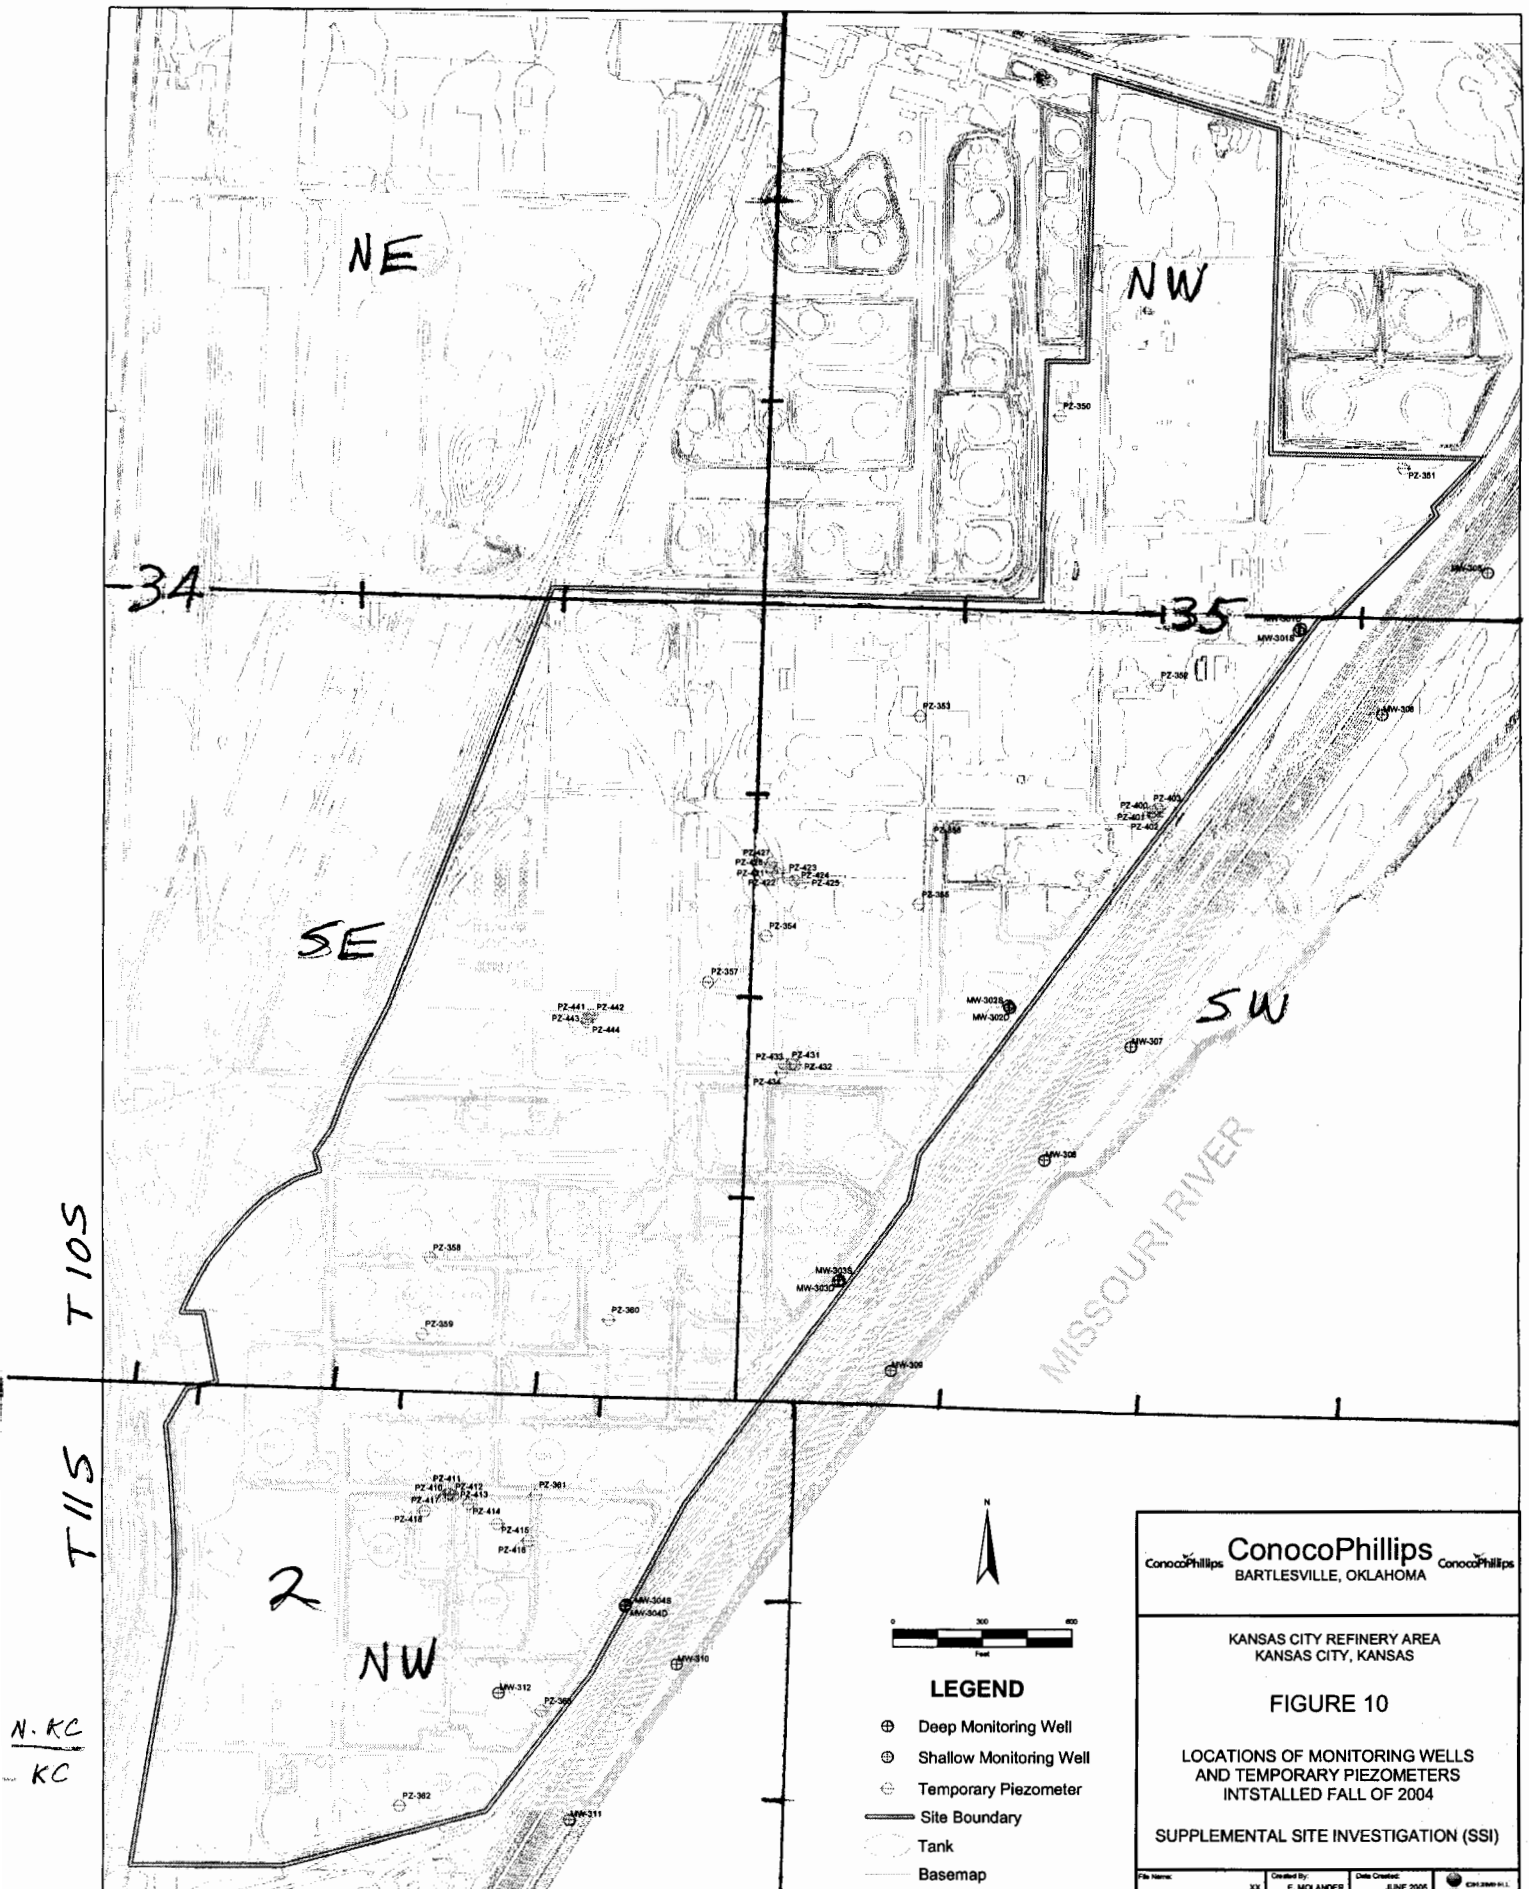

<p><b>ConocoPhillips</b> BARTLESVILLE, OKLAHOMA</p>	
<p>KANSAS CITY REFINERY AREA KANSAS CITY, KANSAS</p>	
<p><b>FIGURE 10</b></p>	
<p>LOCATIONS OF MONITORING WELLS AND TEMPORARY PIEZOMETERS INSTALLED FALL OF 2004</p>	
<p>SUPPLEMENTAL SITE INVESTIGATION (SSI)</p>	
<p>File Name: XX</p>	<p>Created By: E. MOLANDER</p>
<p>Date Created: JUNE 2005</p>	<p>ES&amp;S 3000-01.1</p>