

MW 74

WATER WELL PLUGGING RECORD

Form WWC-5P

KSA 82a-1212


ID NO. _____

1	LOCATION OF WATER WELL:	Fraction SW NW NE NW <small>¼ ¼ ¼</small>	Section Number 2	Township Number 11 5	Range Number 25 EW
---	-------------------------	--	-----------------------------------	--	--

Distance and direction from nearest town or city street address of well if located within city?

2029 Fairfax KCKS 66115

2	WATER WELL OWNER: Conoco Phillips Company RR #, St. Address, Box #: 1218 Phillips Bldg 4205 Lecker Ave City, State, ZIP Code: Bartholomew OK 74004 <small>Board of Agriculture, Division of Water Resources Application Number:</small>
---	---

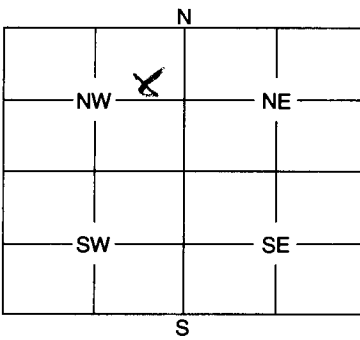3	MARK WELL'S LOCATION WITH AN "X" IN SECTION BOX: <div style="text-align: center;">  </div>
4	DEPTH OF WELL 26.63 ft. WELL'S STATIC WATER LEVEL ft. WELL WAS USED AS: <div style="display: flex; justify-content: space-between;"> <div> 1 Domestic 2 Irrigation 3 Feedlot 4 Industrial </div> <div> 5 Public Water Supply 6 Oil Field Water Supply 7 Domestic (Lawn & Garden) 8 Air Conditioning </div> <div> 9 Dewatering <input checked="" type="checkbox"/> 10 Monitoring Well 11 Injection Well 12 Other </div> </div> <p>Was a chemical / bacteriological sample submitted to Department? Yes No X..... If yes, mo/day/yr sample was submitted</p> <p>Water Well Disinfected: Yes No X.....</p>

5	TYPE OF BLANK CASING USED: <div style="display: flex; justify-content: space-between;"> <div> 1 Steel <input checked="" type="checkbox"/> 2 PVC 3 RMP (SR) 4 ABS </div> <div> 5 Wrought 6 Asbestos-Cement </div> <div> 7 Fiberglass 8 Concrete Tile </div> <div> 9 Other (Specify below) </div> </div> <p>Blank casing diameter 2 in. Was casing pulled? Yes X No If yes, how much 14 in.</p> <p>Casing height above or below land surface 29 in.</p>
---	--


6	GROUT PLUG MATERIAL: 1 Neat cement <input checked="" type="checkbox"/> 2 Cement grout 3 Bentonite 4 Other Grout Plug Intervals: From 26.63 to 0 ft. From ft. to ft. From ft. to ft. What is the nearest source of possible contamination: <div style="display: flex; justify-content: space-between;"> <div> 1 Septic tank 2 Sewer lines 3 Watertight sewer lines 4 Lateral lines 5 Cess pool </div> <div> 6 Seepage pit 7 Pit privy 8 Sewage lagoon 9 Feedyard 10 Livestock pens </div> <div> <input checked="" type="checkbox"/> 11 Fuel storage 12 Fertilizer storage 13 Insecticide storage 14 Abandoned water well 15 Oil well/Gas well </div> <div> 16 Other (specify below) </div> </div> <p>Direction from well? How many feet?</p>
---	---

FROM	TO	PLUGGING MATERIALS
26.63	0	Cement Grout

7	CONTRACTOR'S OR LANDOWNER'S CERTIFICATION: This water well was plugged under my jurisdiction and was completed on (mo/day/year) 11-30-04 and this record is true to the best of my knowledge and belief. Kansas Water Well Contractor's License No. 2-11-03 This Water Well Record was completed on (mo/day/year) by (signature) David H. Smith under the business name of MAXS
---	--

INSTRUCTIONS: Use typewriter or ball point pen. Please press firmly and print clearly. Please fill in blanks, underline or circle the correct answers. Send top three copies to Kansas Department of Health and Environment, Bureau of Water, Geology Section, 1000 SW Jackson St., Ste. 420, Topeka, Kansas 66612-1367. Telephone: 785/296-5522. Send one to Water Well Owner and retain one for your records.

R25E

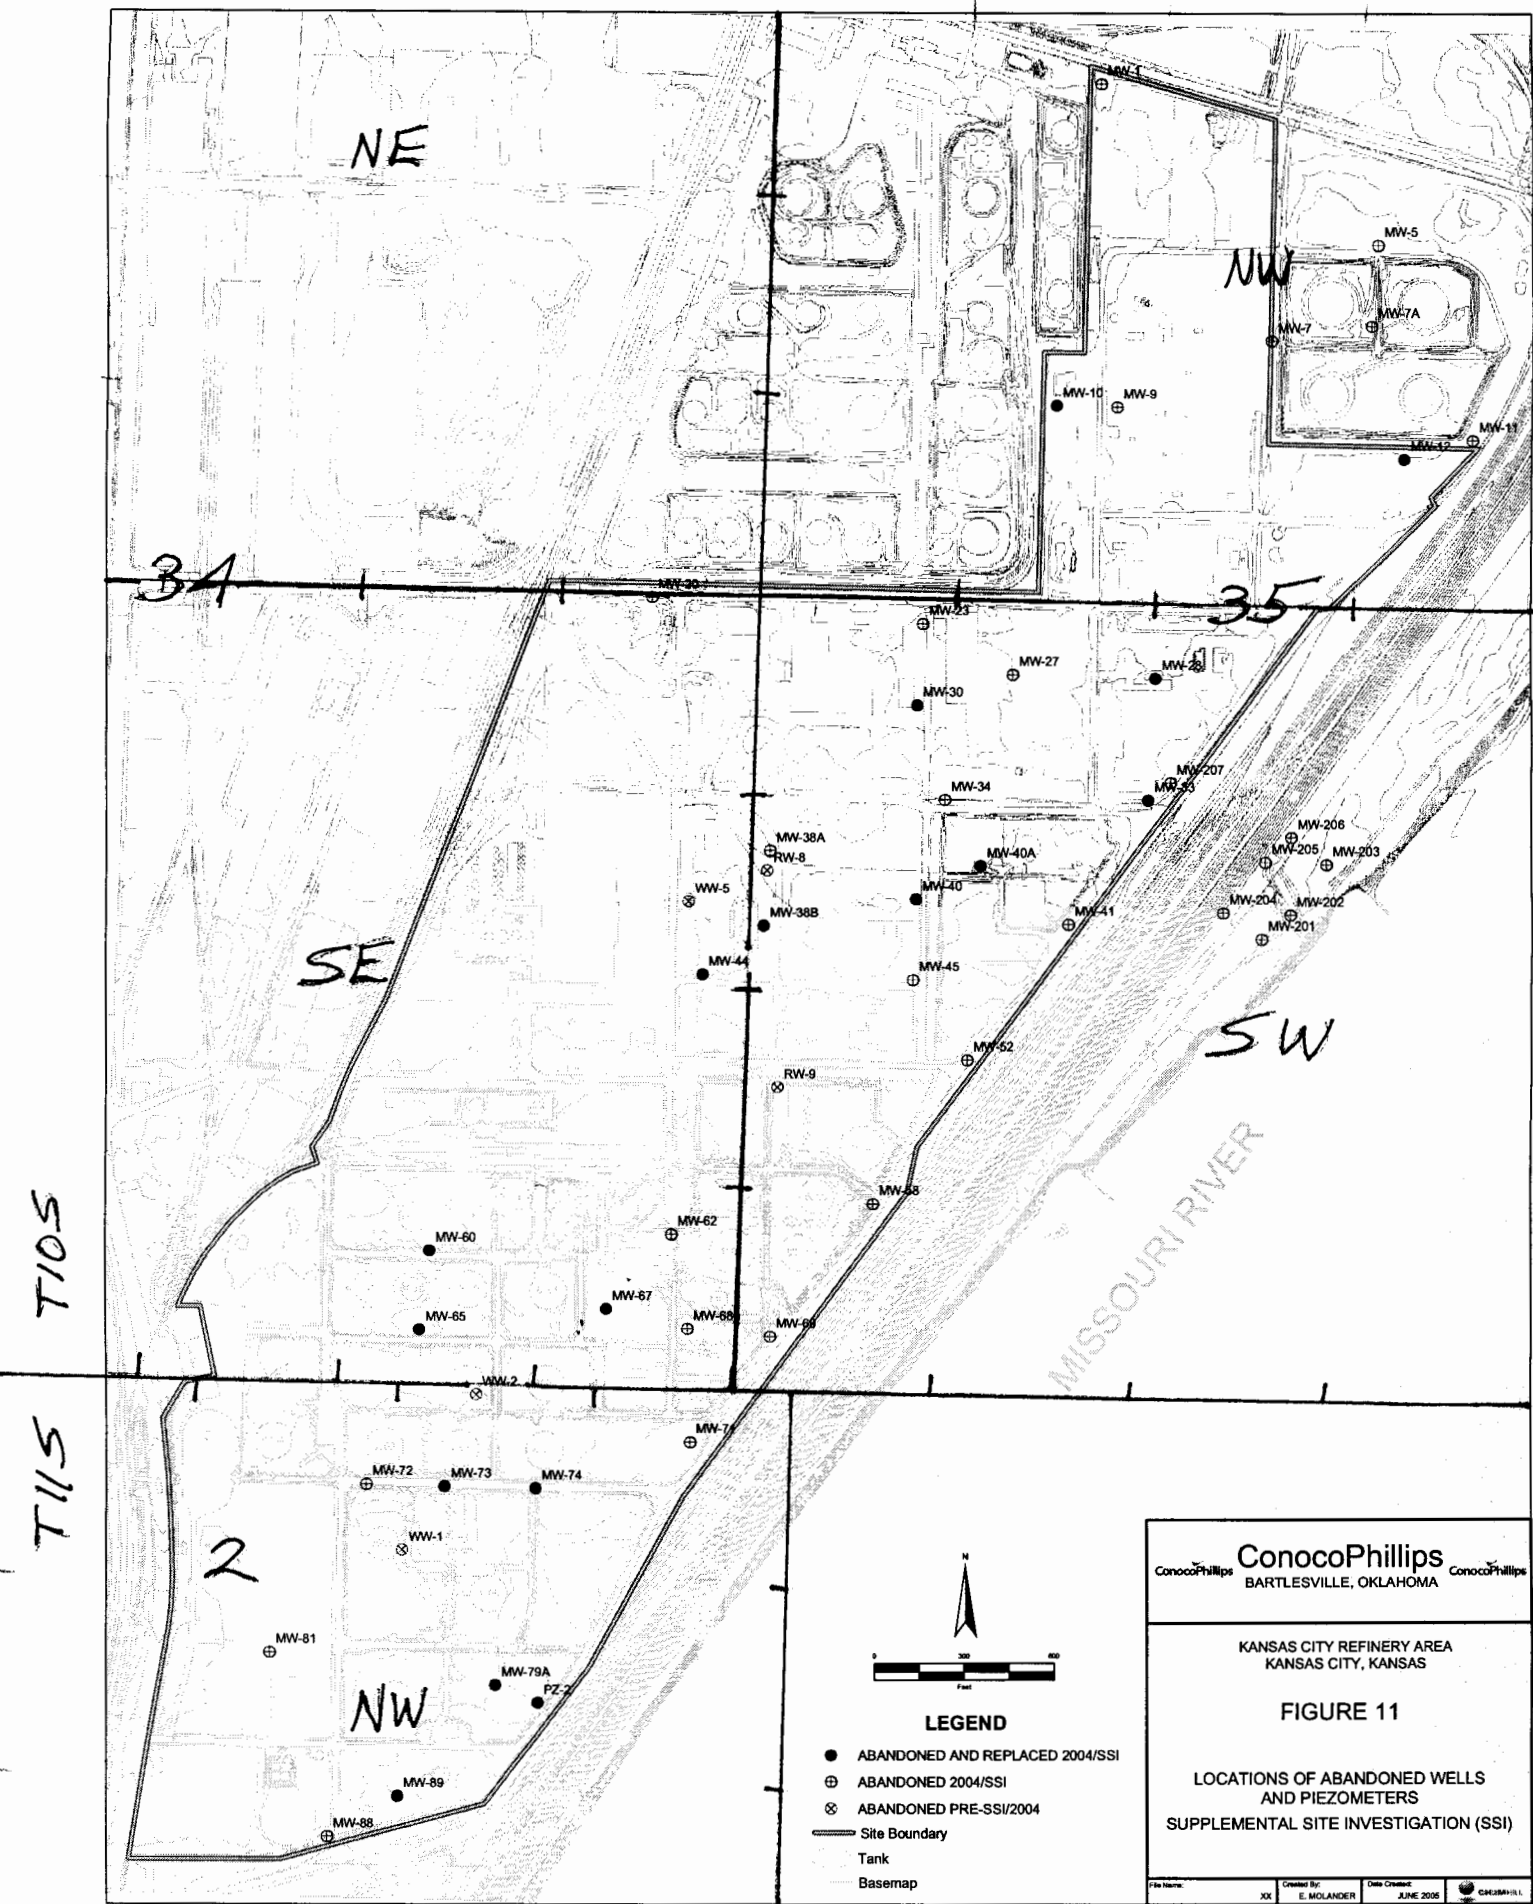

ConocoPhillips
BARTLESVILLE, OKLAHOMA

KANSAS CITY REFINERY AREA
KANSAS CITY, KANSAS

FIGURE 11

LOCATIONS OF ABANDONED WELLS
AND PIEZOMETERS
SUPPLEMENTAL SITE INVESTIGATION (SSI)

File Name:	Created By:	Date Created:	GHE/MILL
XX	E. MOLANDER	JUNE 2005	