

CORRECTION(S) TO WATER WELL RECORD (WWC-5)

(to rectify lacking or incorrect information)

County: Wyandotte

Location listed as:

Location changed to:

Section-Township-Range: 2-11S-25E

2-11S-25E

Fraction ($\frac{1}{4}$ $\frac{1}{4}$ $\frac{1}{4}$): NW NE NW

W2 NW NE NW

Other changes: Initial statements: _____

Changed to: _____

Comments: _____

verification method: Map of well locations from owner, and
North Kansas City 1:24,000 topo. map.

initials: ARL date: 9/15/2005

submitted by: Kansas Geological Survey, Data Resources Library, 1930 Constant Ave., Lawrence, KS 66047-3726
to: Kansas Dept of Health & Environment, Bureau of Water, 1000 SW Jackson, Suite 420, Topeka, KS 66612-1367.

1 LOCATION OF WATER WELL: Fraction NW 1/4 NE 1/4 NW 1/4 Section Number 2 Township Number T 11 S Range Number R 25 E/W	
Distance and direction from nearest town or city street address of well if located within city? 2029 Fairfax Rcks 66115	
2 WATER WELL OWNER: Conoco Phillips Company RR#, St. Address, Box # : 1218 Phillips Bldg 4205 Keeler Ave City, State, ZIP Code : Bartlesville OK 74004 Board of Agriculture, Division of Water Resources Application Number:	
3 LOCATE WELL'S LOCATION WITH AN "X" IN SECTION BOX: N W E S 4 DEPTH OF COMPLETED WELL 35 ft. ELEVATION: Depth(s) Groundwater Encountered 1 ft. 2 ft. 3 ft. WELL'S STATIC WATER LEVEL ft. below land surface measured on mo/day/yr Pump test data: Well water was ft. after hours pumping gpm Est. Yield gpm: Well water was ft. after hours pumping gpm WELL WATER TO BE USED AS: 5 Public water supply 8 Air conditioning 11 Injection well 1 Domestic 3 Feedlot 6 Oil field water supply 9 Dewatering 12 Other (Specify below) 2 Irrigation 4 Industrial 7 Domestic (lawn & garden) 10 Monitoring well P2 412 Was a chemical/bacteriological sample submitted to Department? Yes No; If yes, mo/day/yr sample was submitted Water Well Disinfected? Yes No	
5 TYPE OF BLANK CASING USED: 1 Steel 3 RMP (SR) 5 Wrought iron 8 Concrete tile CASING JOINTS: Glued Clamped 2 PVC 4 ABS 6 Asbestos-Cement 9 Other (specify below) Welded Blank casing diameter 2 in. Dia 15 ft. Dia Casing height above land surface 29 ft. weight lbs./ft. Wall thickness or gauge No. TYPE OF SCREEN OR PERFORATION MATERIAL: 1 Steel 3 Stainless Steel 5 Fiberglass 8 RMP (SR) 10 Asbestos-Cement 2 Brass 4 Galvanized Steel 6 Concrete tile 9 ABS 11 Other (Specify) 12 None used (open hole) SCREEN OR PERFORATION OPENINGS ARE: 1 Continuous slot 2 Mill slot 5 Guazed wrapped 8 Saw cut 11 None (open hole) 2 Louvered shutter 4 Key punched 6 Wire wrapped 9 Drilled holes 7 Torch cut 10 Other (specify) SCREEN-PERFORATED INTERVALS: From 35 ft. to 15 ft. From ft. to ft. GRAVEL PACK INTERVALS: From 35 ft. to 13 ft. From ft. to ft.	
6 GROUT MATERIAL: 1 Neat cement 2 Cement grout 3 Bentonite 4 Other 2' Chip 1' Cement grout Grout Intervals: From ft. to ft. From ft. to ft. From ft. to ft. What is the nearest source of possible contamination: 1 Septic tank 4 Lateral lines 7 Pit privy 10 Livestock pens 14 Abandoned water well 2 Sewer lines 5 Cess pool 8 Sewage lagoon 11 Fuel storage 15 Oil well/Gas well 3 Watertight sewer lines 6 Seepage pit 9 Feedyard 12 Fertilizer storage 16 Other (specify below) 13 Insecticide storage Direction from well? How many feet?	
FROM TO LITHOLOGIC LOG FROM TO PLUGGING INTERVALS 0 24.5 Brk Silty Clay 24.5 35 Brk Silty Sand	
7 CONTRACTOR'S OR LANDOWNER'S CERTIFICATION: This water well was (1) constructed, (2) reconstructed, or (3) plugged under my jurisdiction and was completed on (mo/day/year) 11-4-84 and this record is true to the best of my knowledge and belief. Kansas Water Well Contractor's Licence No 709 This Water Well Record was completed on (mo/day/yr) 11-4-84 under the business name of MAXS by (signature) David Blum	
INSTRUCTIONS: Use typewriter or ball point pen. PLEASE PRESS FIRMLY and PRINT clearly. Please fill in blanks, underline or circle the correct answers. Send top three copies to Kansas Department of Health and Environment, Bureau of Water, Geology Section, 1000 SW Jackson St., Suite 420, Topeka, Kansas 66612-1367. Telephone 785-296-5522. Send one to WATER WELL OWNER and retain one for your records. Fee of \$5.00 for each constructed well.	




PROJECT NUMBER 321564.SI.01	BORING NUMBER PZ-412
SHEET 1 OF 1	
SOIL BORING LOG	

PROJECT : Conoco Phillips - Supplemental SI	NORTHING: 307244.06 EASTING: 2274634.80
ELEVATION : 751.92 ft b.t.o.c.	DRILLING CONTRACTOR : Max's Enterprises Inc.
DRILLING METHOD AND EQUIPMENT USED : CME 750 Rig, HSA	LOGGER : C. Morris
WATER LEVELS : 30' bgs	START : 11/04/04 1410 END : 11/04/04 1445

DEPTH BELOW SURFACE (FT)	INTERVAL (FT)	RECOVERY (FT)	#/TYPE	STANDARD PENETRATION TEST RESULTS	SOIL DESCRIPTION	COMMENTS
				6"-6"-6" (N)	SOIL NAME, USCS GROUP SYMBOL, COLOR, MOISTURE CONTENT, RELATIVE DENSITY, OR CONSISTENCY, SOIL STRUCTURE, MINERALOGY.	DEPTH OF CASING, DRILLING RATE, DRILLING FLUID LOSS, TESTS, AND INSTRUMENTATION.
						Notes
	No Soil Sampling				0.0': Clay and gravel fill, dark brown, moist, slightly firm, loose, angular gray gravel	
5					4.0': Clay fill with some fine gravel, dark brown, moist, soft	
					6.0': Clay fill with gravel, brown gray, moist, medium firm, slight HC odor	
10					9.0': Grading drier, firm, slight odor	
					12.0': Silty clay with gravel (CL), brownish gray, slightly moist, medium stiff, fill, HC odor	
15					16.0': Silty clay with gravel (CL), medium gray, slightly moist, medium stiff, fine to coarse gravel, HC odor	
					18.0': Gravel grading finer	
20					20.0': Silty clay with trace fine gravel (CL), medium gray, moist, soft, HC odor (light smelling product)	
					24.5': Silty sand (SM), gray, crumbly, slightly moist, poorly graded, HC odor	
25					30.0': Silty sand (SM), gray, wet with product, soft, sheen, oily, strong HC odor	
					34.0': Sheen, oily appearance less	
35					35.0': End of boring	

R25E

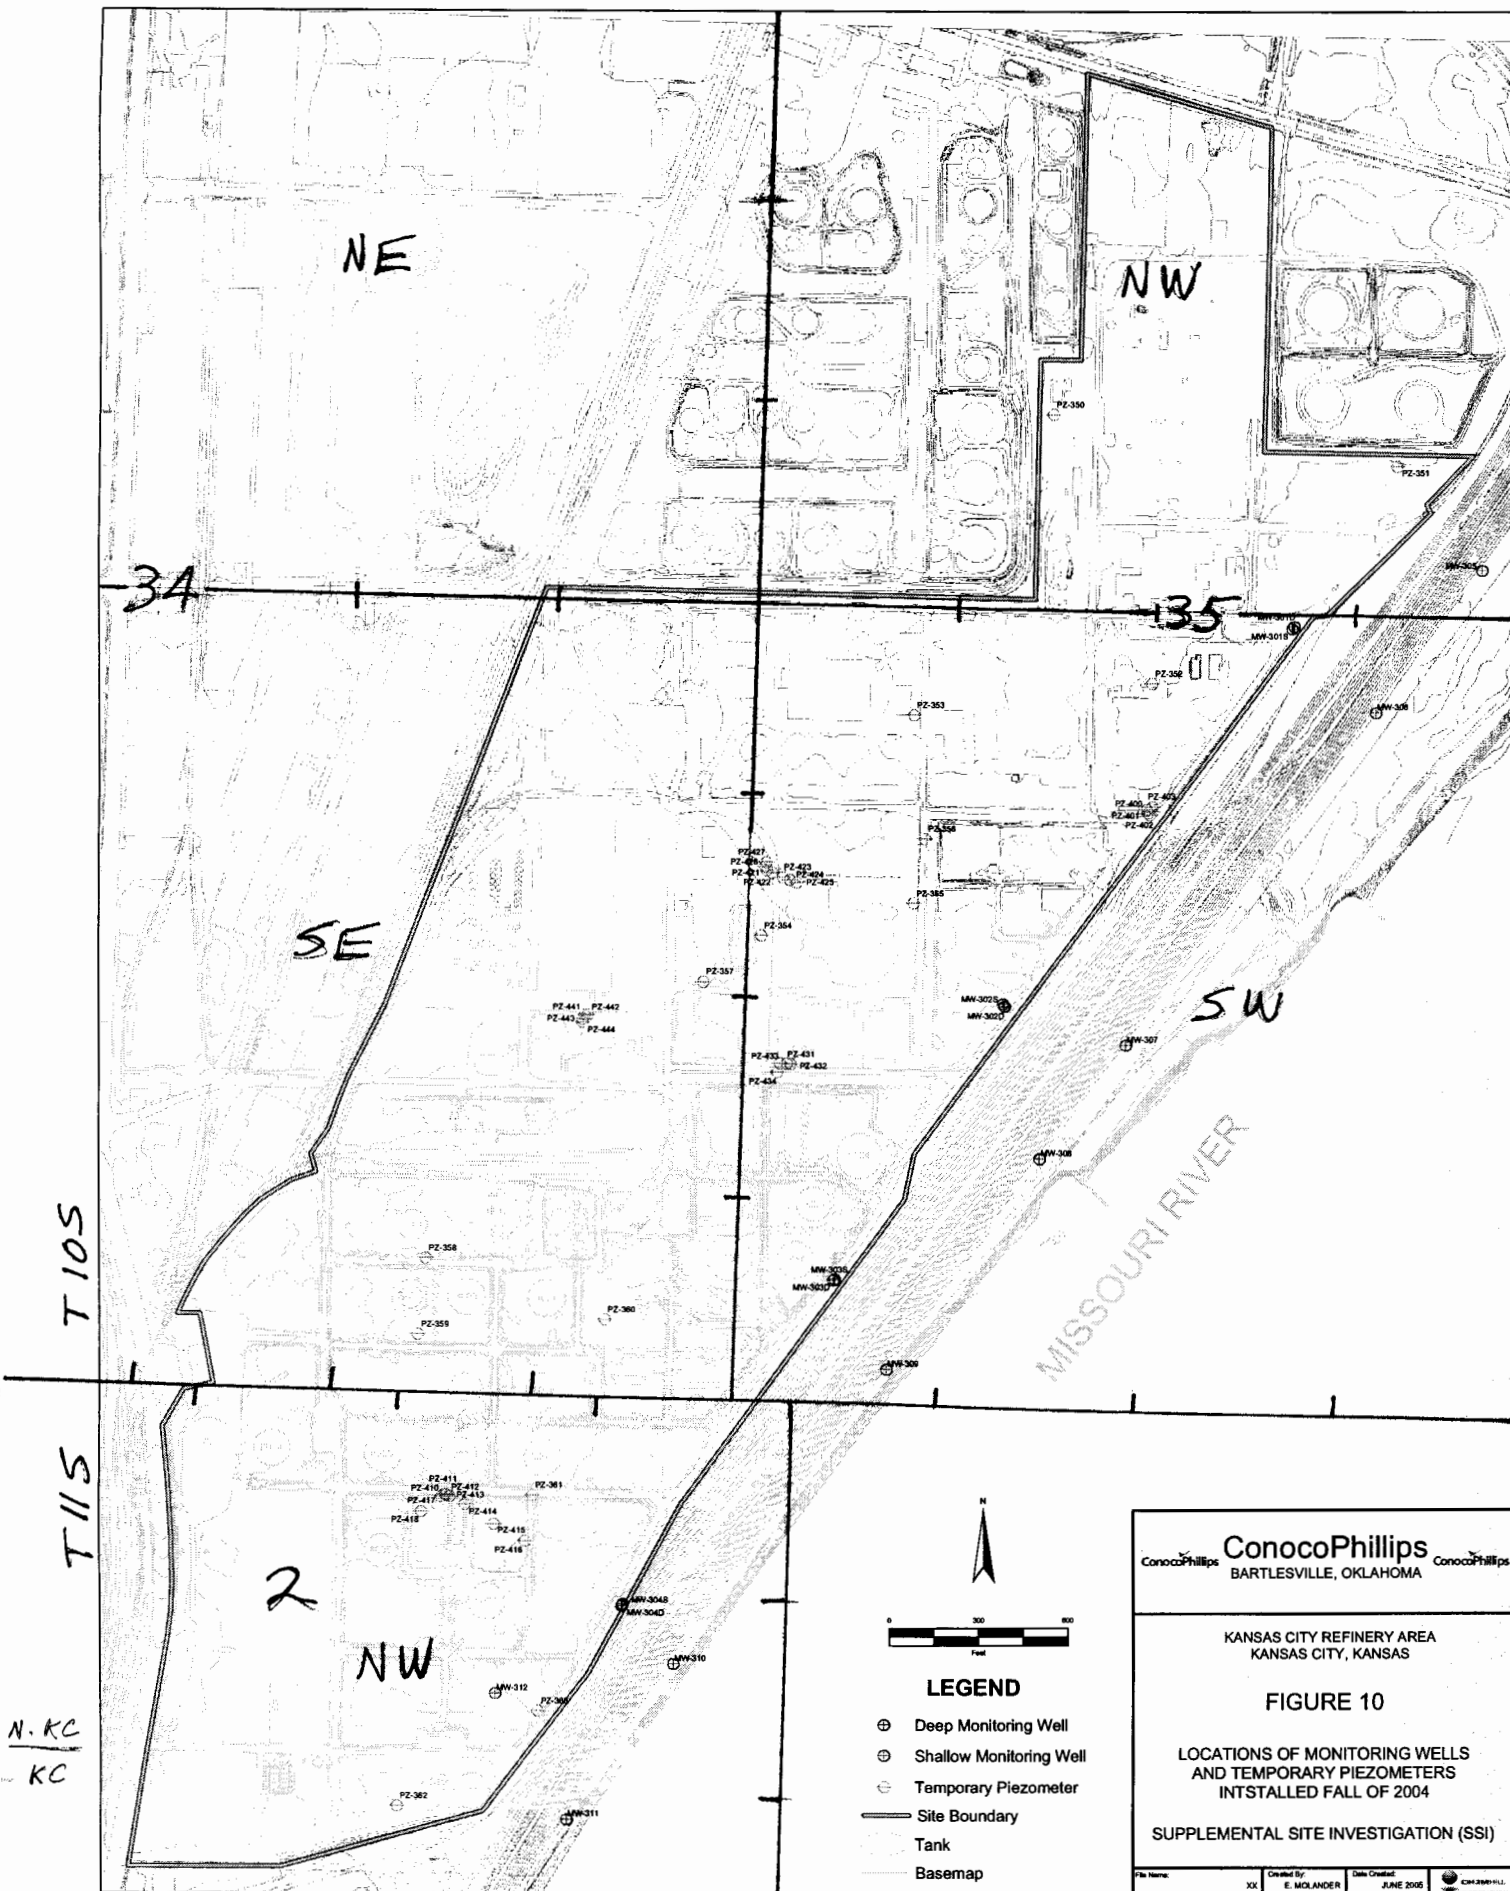

ConocoPhillips BARTLESVILLE, OKLAHOMA

KANSAS CITY REFINERY AREA
KANSAS CITY, KANSAS

FIGURE 10

LOCATIONS OF MONITORING WELLS
AND TEMPORARY PIEZOMETERS
INSTALLED FALL OF 2004

SUPPLEMENTAL SITE INVESTIGATION (SSI)

File Name:	Created By:	Date Created:	ConocoPhillips
XX	E. MCLANDER	JUNE 2005	CHM 2005/06/01