

**CORRECTION(S) TO WATER WELL RECORD (WWC-5)**

(to rectify lacking or incorrect information)

County: Wyandotte

Location listed as:

Section-Township-Range: 2-115-25E

Fraction (  $\frac{1}{4}$   $\frac{1}{4}$   $\frac{1}{4}$ ): NW NE NW

Location changed to:

2-115-25E

W2 NW NE NW

Other changes: Initial statements: \_\_\_\_\_

Changed to: \_\_\_\_\_

Comments: \_\_\_\_\_

verification method: Map of well locations from owner, and  
North Kansas City 1:24,000 topo. map.

initials: ARA date: 9/15/2005

submitted by: Kansas Geological Survey, Data Resources Library, 1930 Constant Ave., Lawrence, KS 66047-3726  
to: Kansas Dept of Health & Environment, Bureau of Water, 1000 SW Jackson, Suite 420, Topeka, KS 66612-1367.

PZ 414

\_\_\_\_\_




<b>PROJECT NUMBER</b> 321564.SI.01	<b>BORING NUMBER</b> PZ-414
SHEET 1 OF 1	
<b>SOIL BORING LOG</b>	

<b>PROJECT :</b> Conoco Phillips - Supplemental SI	<b>NORTHING:</b> 307215.02 <b>EASTING:</b> 2274694.66
<b>ELEVATION :</b> 744.46 ft b.t.o.c.	<b>DRILLING CONTRACTOR :</b> Max's Enterprises Inc.
<b>DRILLING METHOD AND EQUIPMENT USED :</b> CME 750 Rig, HSA	<b>LOGGER :</b> C. Morris
<b>WATER LEVELS :</b> 30' bgs	<b>START :</b> 11/05/04 1045 <b>END :</b> 1150

DEPTH BELOW SURFACE (FT)	INTERVAL (FT)	RECOVERY (FT)	#/TYPE	STANDARD PENETRATION TEST RESULTS	SOIL DESCRIPTION	COMMENTS
				6"-6"-6" (N)	SOIL NAME, USCS GROUP SYMBOL, COLOR, MOISTURE CONTENT, RELATIVE DENSITY, OR CONSISTENCY, SOIL STRUCTURE, MINERALOGY.	DEPTH OF CASING, DRILLING RATE, DRILLING FLUID LOSS, TESTS, AND INSTRUMENTATION.
						Notes
	No Soil Sampling				0.0': Silty clay (CL), brown with some gray staining, moist, soft, slight HC odor	
5					3.0': Silty clay (CL), dark gray, moist, medium stiff, HC odor	
					5.0': Silty clay (CL), dark gray, moist, soft, strong HC/chemical odor	
10					8.0': Silty clay with sand (CL), dark gray, moist, soft, strong odor, possible sheen	
15					15.0': Elastic sandy silt (MH), moist, soft, strong odor, sheen	
					17.0': Silty sand (SM), dark olive gray, moist, poorly graded, strong odor	
20					25.0': Silty sand (SM), dark olive gray, wet to saturated with product, sheen, very strong odor, poorly graded (product drains from sand)	
30					38.0': Poorly graded sand with gravel (SP), dark gray, wet to saturated, fine to coarse, gravel rounded and variable colors, oily sheen/iridescent	
40					40.0': End of boring	

R 25 E

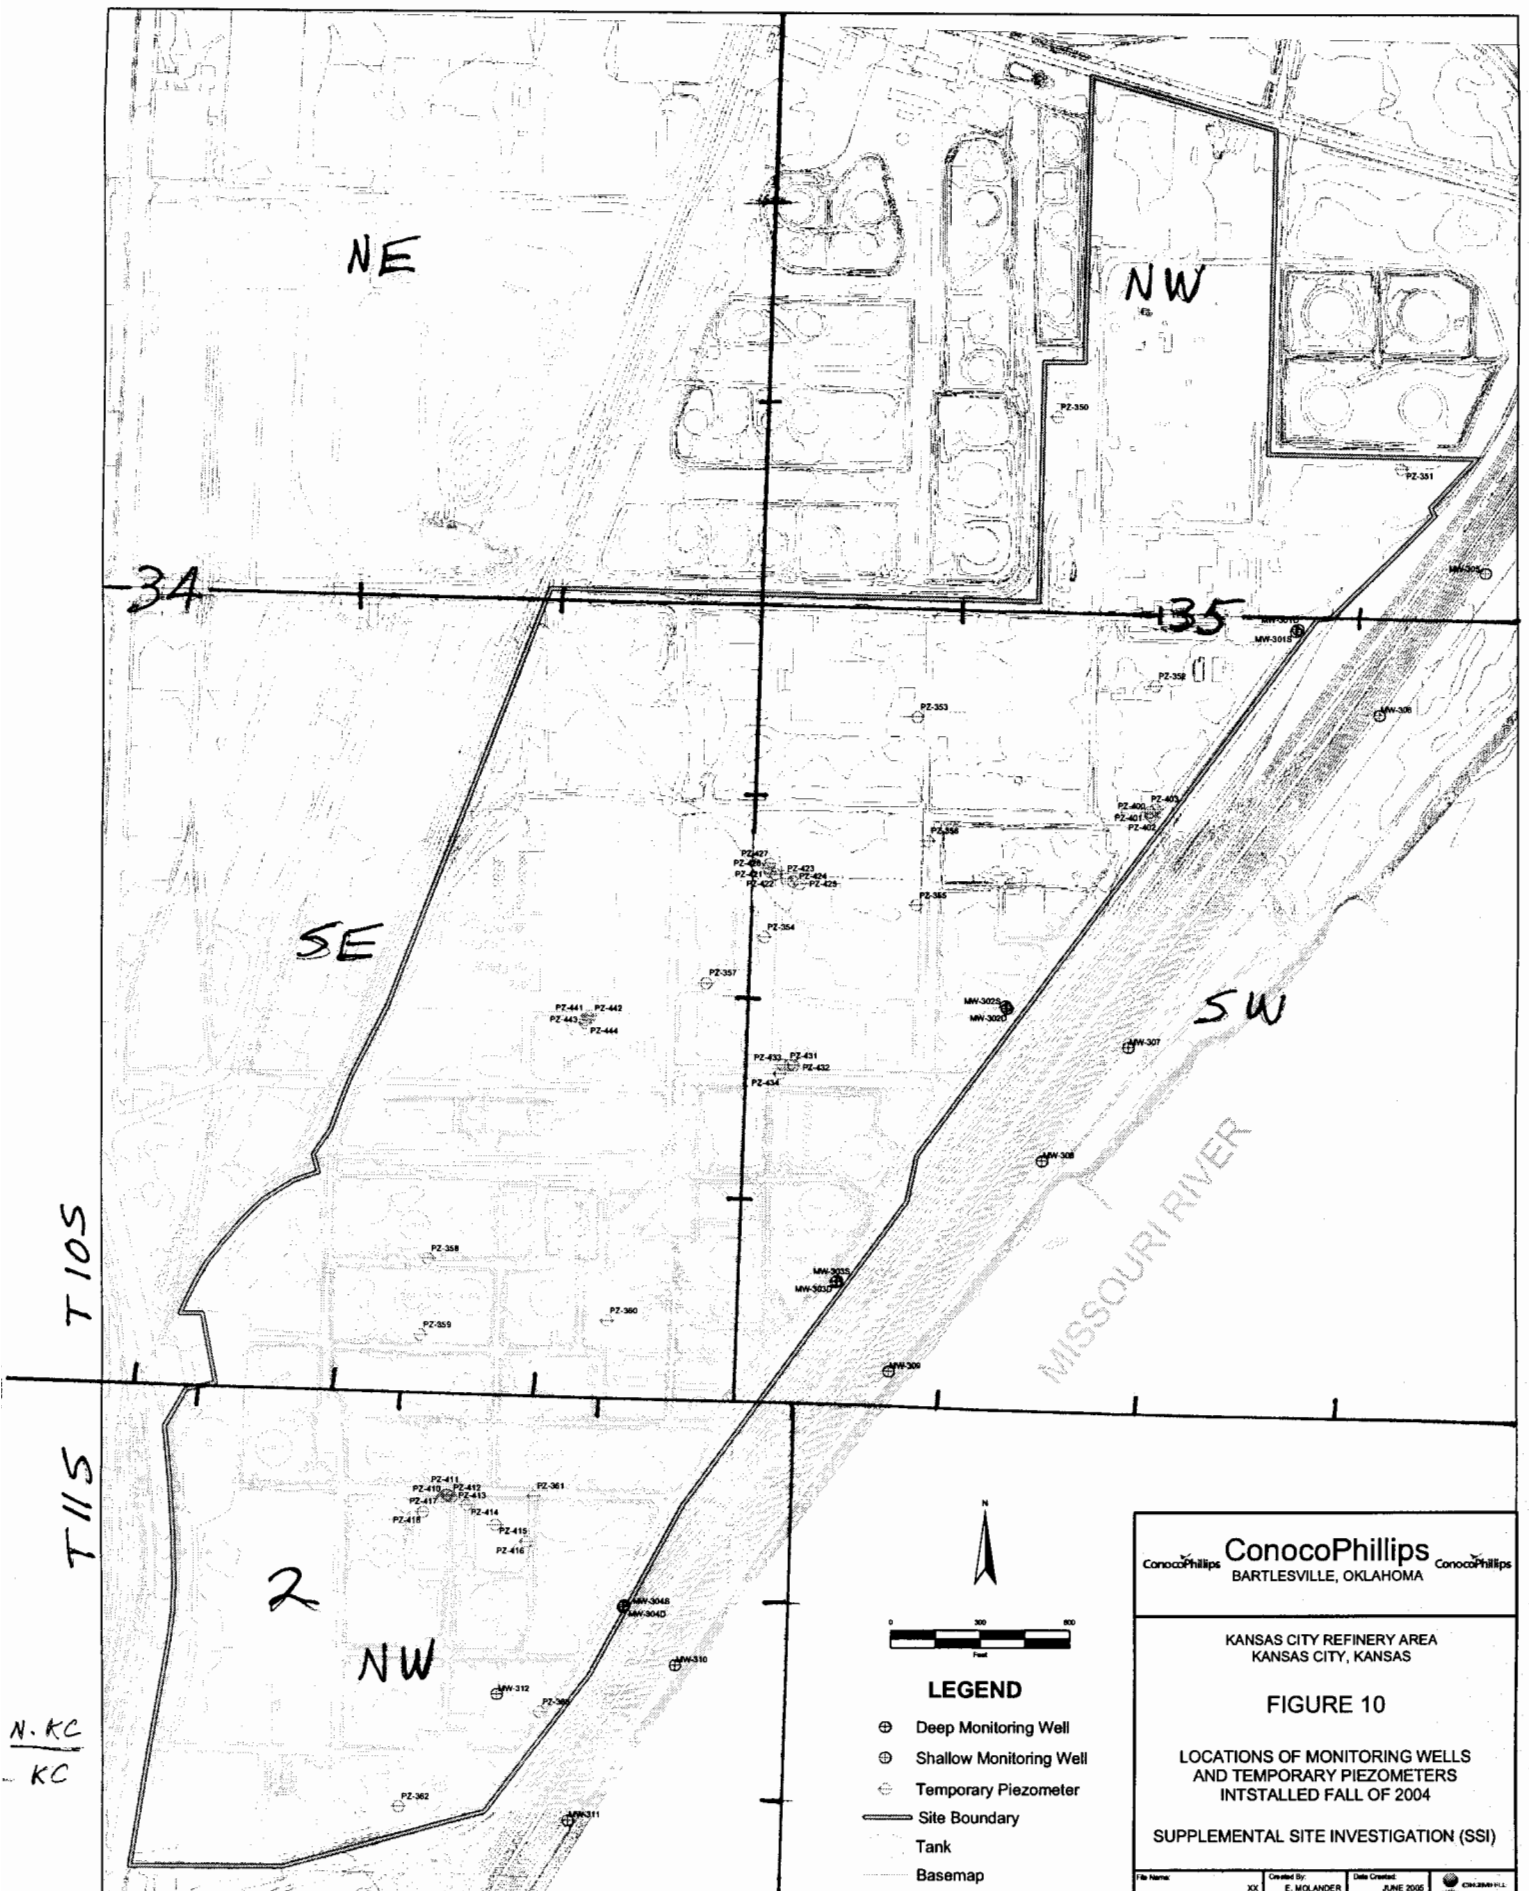

<p>ConocoPhillips</p> <p><b>ConocoPhillips</b></p> <p>BARTLESVILLE, OKLAHOMA</p>			
<p>KANSAS CITY REFINERY AREA</p> <p>KANSAS CITY, KANSAS</p>			
<p><b>FIGURE 10</b></p>			
<p>LOCATIONS OF MONITORING WELLS AND TEMPORARY PIEZOMETERS INSTALLED FALL OF 2004</p>			
<p>SUPPLEMENTAL SITE INVESTIGATION (SSI)</p>			
File Name:	Created By:	Date Created:	CSL20041112
XX	E. MOLLANDER	JUNE 2005	