

## CORRECTION(S) TO WATER WELL RECORD (WWC-5)

(to rectify lacking or incorrect information)

Location listed as:

Section-Township-Range: 2-11S-25EFraction (  $\frac{1}{4}$   $\frac{1}{4}$   $\frac{1}{4}$ ): NW NE NWCounty: Wyandotte  
Location changed to:2-11S-25ES2 NW NE NW

Other changes: Initial statements: \_\_\_\_\_

Changed to: \_\_\_\_\_

Comments: \_\_\_\_\_

verification method: Map of well locations from owner, andNorth Kansas City 1:24,000 topo. map.initials: DRL date: 9/15/2005

submitted by: Kansas Geological Survey, Data Resources Library, 1930 Constant Ave., Lawrence, KS 66047-3726

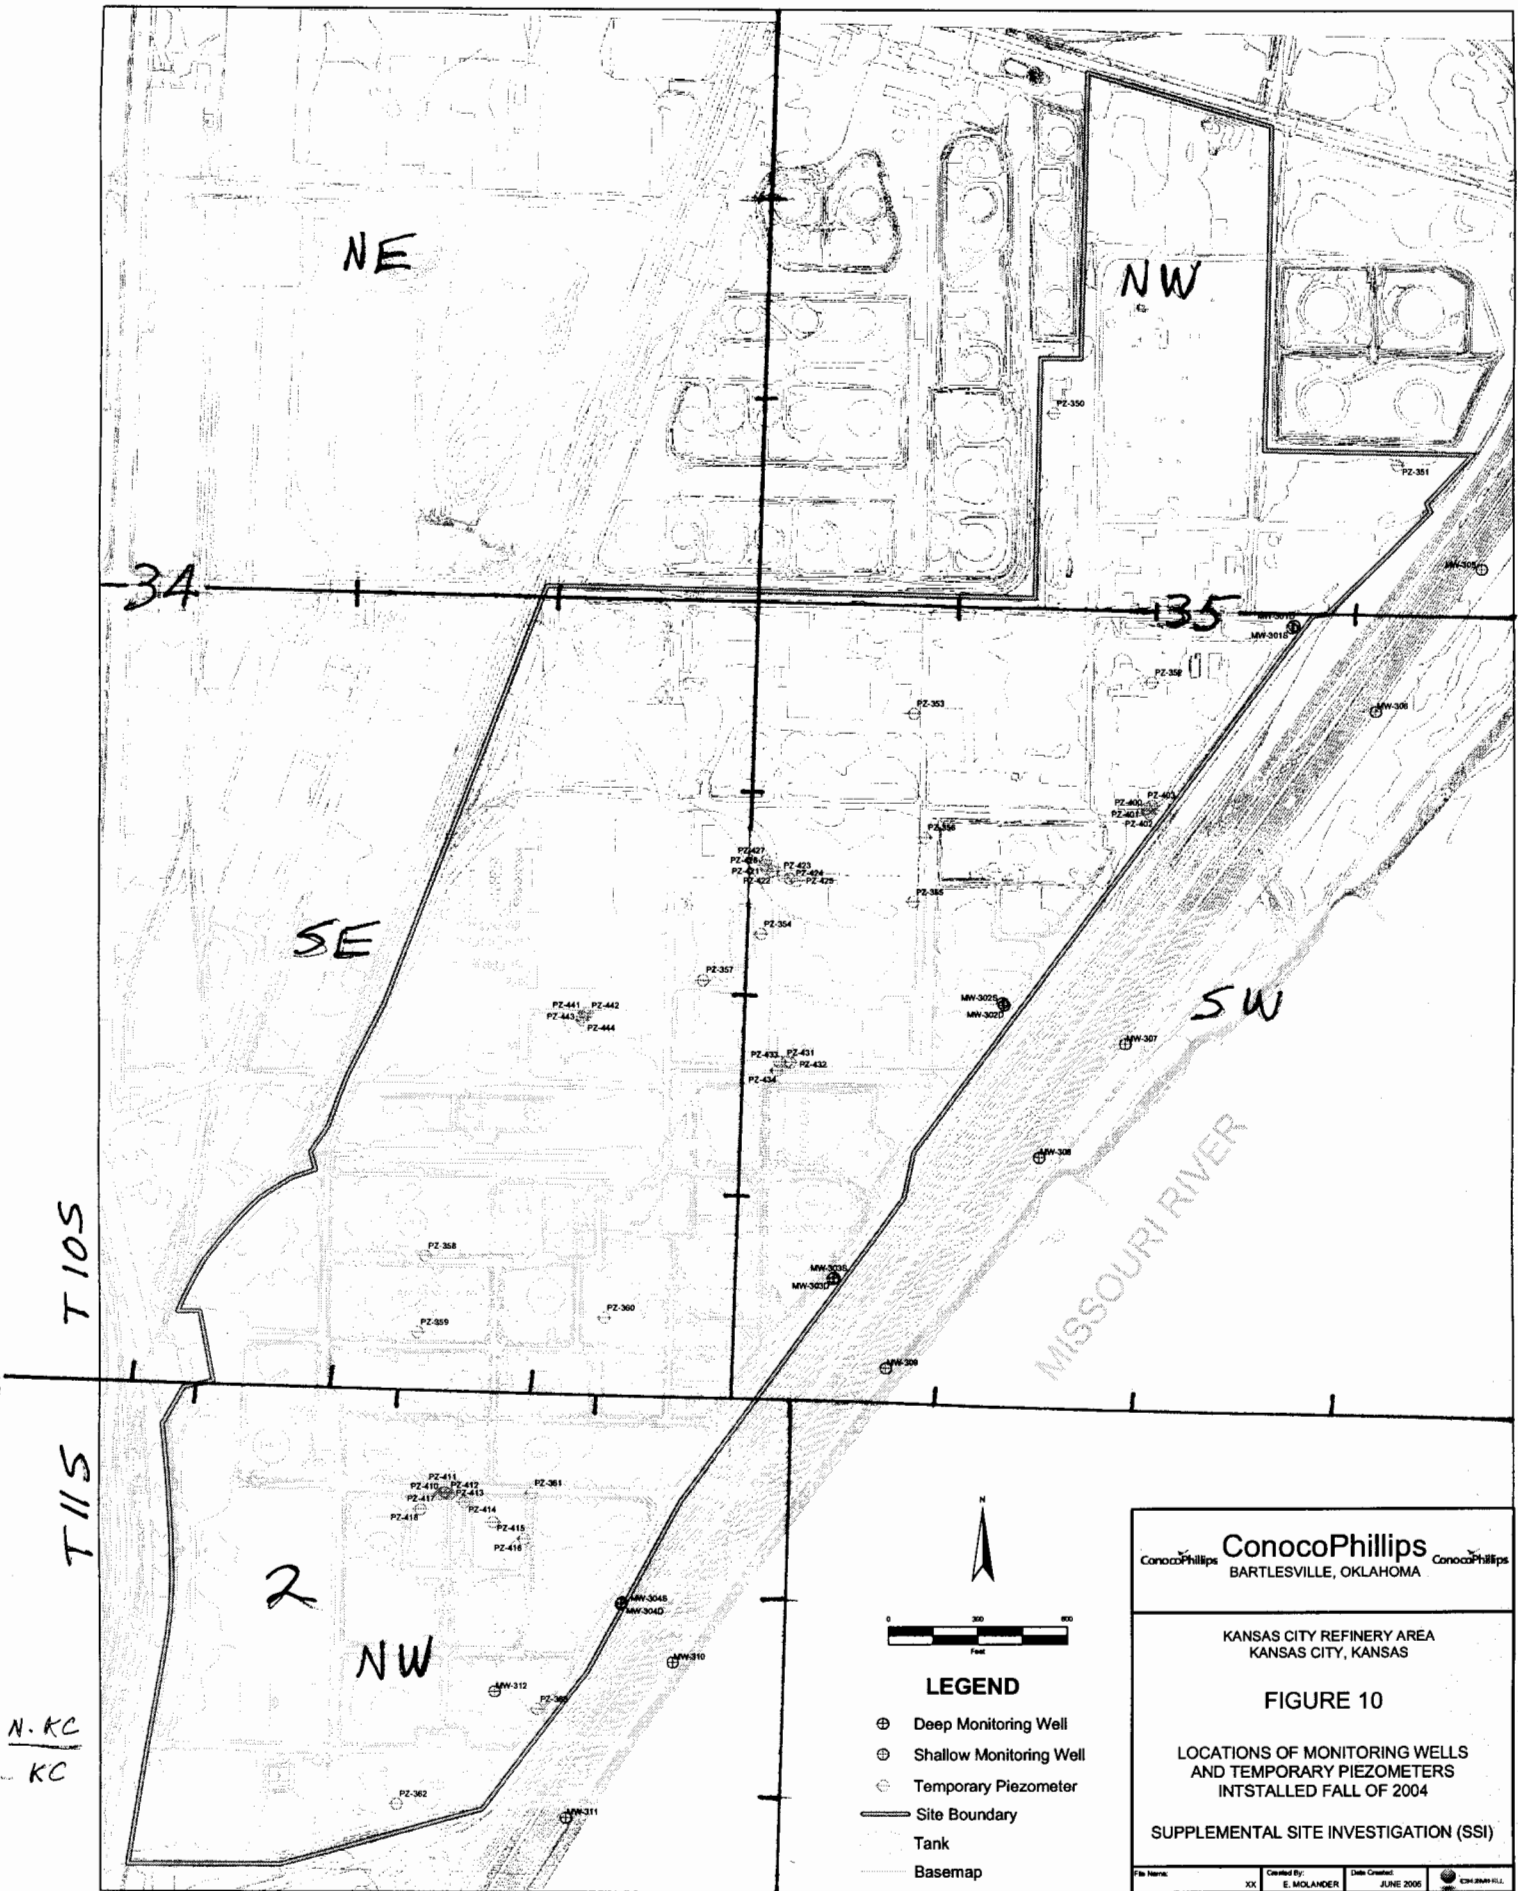
to: Kansas Dept of Health &amp; Environment, Bureau of Water, 1000 SW Jackson, Suite 420, Topeka, KS 66612-1367.



INSTRUCTIONS: Use typewriter or ball point pen. PLEASE PRESS FIRMLY, and PRINT clearly. Please fill in blanks, underline or circle the correct answers. Send top three copies to Kansas Department of Health and Environment, Bureau of Water, Geology Section, 1000 SW Jackson St., Suite 420, Topeka, Kansas 66612-1367. Telephone 785-296-5522. Send one to WATER WELL OWNER and retain one for your records. Fee of \$5.00 for each constructed well.



PROJECT : Conoco Phillips - Supplemental SI					NORTHING: 307154.38		EASTING: 2274794.00	
ELEVATION : 742.69 ft b.t.o.c.					DRILLING CONTRACTOR : Max's Enterprises Inc.			
DRILLING METHOD AND EQUIPMENT USED : CME 750 Rig, HSA					LOGGER : C. Morris			
WATER LEVELS : 26' bgs					START : 11/18/04 1435		END : 1500	
DEPTH BELOW SURFACE (FT)				STANDARD	SOIL DESCRIPTION		COMMENTS	
INTERVAL (FT)		RECOVERY (FT)		PENETRATION	SOIL NAME, USCS GROUP SYMBOL, COLOR, MOISTURE CONTENT, RELATIVE DENSITY, OR CONSISTENCY, SOIL STRUCTURE, MINERALOGY.		DEPTH OF CASING, DRILLING RATE, DRILLING FLUID LOSS, TESTS, AND INSTRUMENTATION.	
		#/TYPE		TEST RESULTS				
				6"-6"-6" (N)				
No Soil Sampling					1.0': Silty clay (CL), brown, moist, soft, slight odor		Notes	
					3.0': Grades moist, gray to brown (stained)			
					8.0': Increasing silt, brownish gray, strong HC odor			
					10.0': Elastic silt (MH), gray, moist, soft, strong odor			
					12.0': Sandy silt with clay nodules (ML), brownish gray, moist, fine sand, HC odor			
					14.0': Silty sand (SM), tan to gray, moist, poorly graded, fine, strong odor			
					16.0': Silty sand (SM), tan, moist, poorly graded, fine, odor			
	21.0': Silty sand (SM), olive gray, moist to wet, fine to medium, strong HC odor							
	25.0': Well graded sand (SW), olive gray, wet to saturated, fine to medium, strong HC odor							
	30.0': Grading coarser							
	32.0': Poorly graded sand with some fine gravel (SP), olive gray, wet to saturated, fine to coarse, sheen/iridescence, strong odor							
	33.0': Flowing sand, saturated							
	40.0': End of boring							

R 25 E




**ConocoPhillips**  
 BARTLESVILLE, OKLAHOMA
 

---

**KANSAS CITY REFINERY AREA**  
 KANSAS CITY, KANSAS

---

**FIGURE 10**  
  
 LOCATIONS OF MONITORING WELLS  
 AND TEMPORARY PIEZOMETERS  
 INSTALLED FALL OF 2004  
  
 SUPPLEMENTAL SITE INVESTIGATION (SSI)

---

File Name:	Created By:	Date Created:	
XX	E. MOLANDER	JUNE 2006	CH2M HILL