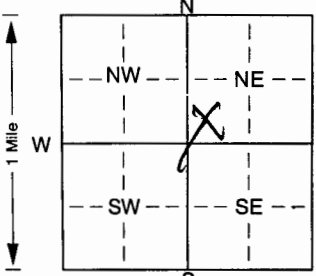


MW-9R

1 LOCATION OF WATER WELL:	Fraction	Section Number	Township Number	Range Number
County: Wyandotte	SW 1/4 NE 1/4 NE 1/4	33	T 11 S	R 25 E

Distance and direction from nearest town or city street address of well if located within city?

2 WATER WELL OWNER:	OS Waters	Sister Oregon 97759	Board of Agriculture, Division of Water Resources
RR#, St. Address, Box #	69495 Lasso		Application Number:
City, State, ZIP Code			

3 LOCATE WELL'S LOCATION WITH AN "X" IN SECTION BOX:	4 DEPTH OF COMPLETED WELL: 20.5 ft. ELEVATION: 802.10 Top Casing
	Depth(s) Groundwater Encountered 1. 14 ft. 2. ft. 3. ft. WELL'S STATIC WATER LEVEL ft. below land surface measured on mo/day/yr Pump test data: Well water was ft. after hours pumping gpm Est. Yield gpm: Well water was ft. after hours pumping gpm Bore Hole Diameter in. to ft. and in. to ft. WELL WATER TO BE USED AS: 5 Public water supply 8 Air conditioning 11 Injection well 1 Domestic 3 Feedlot 6 Oil field water supply 9 Dewatering 12 Other (Specify below) 2 Irrigation 4 Industrial 7 Domestic (lawn & garden) 10 Monitoring well Was a chemical/bacteriological sample submitted to Department? Yes. No. X; If yes, mo/day/yr sample was submitted Water Well Disinfected? Yes No

5 TYPE OF BLANK CASING USED:	5 Wrought iron	8 Concrete tile	CASING JOINTS: Glued. Clamped. Welded. Threaded. ASTM
1 Steel	3 RMP (SR)	6 Asbestos-Cement	9 Other (specify below)
2 PVC	4 ABS	7 Fiberglass	
Blank casing diameter 2 in. to 5 ft. Dia			
Casing height above land surface 2' 6 in. weight 50R lbs./ft. Wall thickness or gauge No. 80			
TYPE OF SCREEN OR PERFORATION MATERIAL:	5 Fiberglass	8 RMP (SR)	10 Asbestos-cement
1 Steel	3 Stainless steel	9 ABS	11 Other (specify)
2 Brass	4 Galvanized steel		12 None used (open hole)
SCREEN OR PERFORATION OPENINGS ARE:	5 Gauzed wrapped	8 Saw cut	11 None (open hole)
1 Continuous slot	6 Wire wrapped	9 Drilled holes	
2 Louvered shutter	7 Torch cut	10 Other (specify)	
3 Mill slot			
4 Key punched			
SCREEN-PERFORATED INTERVALS: From 20.0 ft. to 5.0 ft.			
GRAVEL PACK INTERVALS: From 20.5 ft. to 3.5 ft.			

6 GROUT MATERIAL:	1 Neat cement	2 Cement grout	3 Bentonite	4 Other
Grout Intervals: From ft. to ft.				
What is the nearest source of possible contamination:	10 Livestock pens	14 Abandoned water well		
1 Septic tank	4 Lateral lines	7 Pit privy	11 Fuel storage	15 Oil well/Gas well
2 Sewer lines	5 Cess pool	8 Sewage lagoon	12 Fertilizer storage	16 Other (specify below)
3 Watertight sewer lines	6 Seepage pit	9 Feedyard	13 Insecticide storage	
Direction from well?			How many feet?	

FROM	TO	LITHOLOGIC LOG	FROM	TO	PLUGGING INTERVALS
0.0	0.5	asphalt-gravel			
0.5	6.0	drk gry Fill cly-gravels			
6.0	13.0	drk gry cly-Fuel odor			
13.0	20.0	drk grn gry cly silt			
20.0	20.5	gry brn cly with L.S. gravels			

7 CONTRACTOR'S OR LANDOWNER'S CERTIFICATION: This water well was (1) constructed, (2) reconstructed, or (3) plugged under my jurisdiction and was completed on (mo/day/year) 5-9-05 and this record is true to the best of my knowledge and belief. Kansas Water Well Contractor's Licence No. 614 This Water Well Record was completed on (mo/day/yr) under the business name of Maxum by (signature) William Stafford
