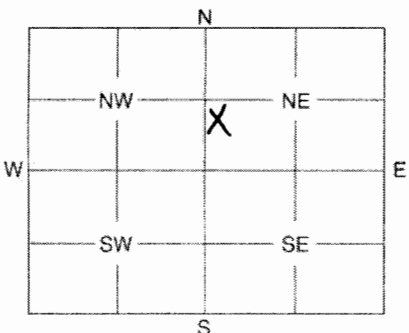


1	LOCATION OF WATER WELL: Wyandotte	Fraction NW ¼ SW ¼ NE ¼	Section Number 31	Township Number 11	Range Number 25
County: Wyandotte					

Distance and direction from nearest town or city street address of well if located within city?

4115 Shawnee Drive, Kansas City, Ks

2	WATER WELL OWNER: KDHE Time and Materials (Mico Oil Co)	
RR #, St. Address, Box #: 1000 SW Jackson #410		Board of Agriculture, Division of Water Resources
City, State, ZIP Code: Topeka, Ks 66612-1367		Application Number:

3	MARK WELL'S LOCATION WITH AN "X" IN SECTION BOX: 	4	DEPTH OF WELL 17 ft. WELL'S STATIC WATER LEVEL 14.63 ft. WELL WAS USED AS: <table border="0"> <tr> <td>1 Domestic</td> <td>5 Public Water Supply</td> <td>9 Dewatering</td> </tr> <tr> <td>2 Irrigation</td> <td>6 Oil Field Water Supply</td> <td>10 Monitoring Well</td> </tr> <tr> <td>3 Feedlot</td> <td>7 Domestic (Lawn & Garden)</td> <td>11 Injection Well</td> </tr> <tr> <td>4 Industrial</td> <td>8 Air Conditioning</td> <td>12 Other</td> </tr> </table>	1 Domestic	5 Public Water Supply	9 Dewatering	2 Irrigation	6 Oil Field Water Supply	10 Monitoring Well	3 Feedlot	7 Domestic (Lawn & Garden)	11 Injection Well	4 Industrial	8 Air Conditioning	12 Other
1 Domestic	5 Public Water Supply	9 Dewatering													
2 Irrigation	6 Oil Field Water Supply	10 Monitoring Well													
3 Feedlot	7 Domestic (Lawn & Garden)	11 Injection Well													
4 Industrial	8 Air Conditioning	12 Other													
Was a chemical / bacteriological sample submitted to Department? Yes No X															
If yes, mo/day/yr sample was submitted															
Water Well Disinfected: Yes No X															

5	TYPE OF BLANK CASING USED:											
<table border="0"> <tr> <td>1 Steel</td> <td>3 RMP (SR)</td> <td>5 Wrought</td> <td>7 Fiberglass</td> <td>9 Other (Specify below)</td> </tr> <tr> <td>2 PVC</td> <td>4 ABS</td> <td>6 Asbestos-Cement</td> <td>8 Concrete Tile</td> <td></td> </tr> </table>			1 Steel	3 RMP (SR)	5 Wrought	7 Fiberglass	9 Other (Specify below)	2 PVC	4 ABS	6 Asbestos-Cement	8 Concrete Tile	
1 Steel	3 RMP (SR)	5 Wrought	7 Fiberglass	9 Other (Specify below)								
2 PVC	4 ABS	6 Asbestos-Cement	8 Concrete Tile									
Blank casing diameter in. Was casing pulled? Yes X No If yes, how much 20'												
Casing height above or below land surface in.												

6	GROUT PLUG MATERIAL:																					
<table border="0"> <tr> <td>1 Neat cement</td> <td>2 Cement grout</td> <td>3 Bentonite</td> <td>4 Other</td> </tr> </table>		1 Neat cement	2 Cement grout	3 Bentonite	4 Other																	
1 Neat cement	2 Cement grout	3 Bentonite	4 Other																			
Grout Plug Intervals: From 17 ft. to .5 ft., From .5 ft. to 0 ft., From to ft.																						
What is the nearest source of possible contamination:																						
<table border="0"> <tr> <td>1 Septic tank</td> <td>6 Seepage pit</td> <td>11 Fuel storage</td> <td>16 Other (specify below)</td> </tr> <tr> <td>2 Sewer lines</td> <td>7 Pit privy</td> <td>12 Fertilizer storage</td> <td>cont. site</td> </tr> <tr> <td>3 Watertight sewer lines</td> <td>8 Sewage lagoon</td> <td>13 Insecticide storage</td> <td></td> </tr> <tr> <td>4 Lateral lines</td> <td>9 Feedyard</td> <td>14 Abandoned water well</td> <td></td> </tr> <tr> <td>5 Cess pool</td> <td>10 Livestock pens</td> <td>15 Oil well/Gas well</td> <td></td> </tr> </table>			1 Septic tank	6 Seepage pit	11 Fuel storage	16 Other (specify below)	2 Sewer lines	7 Pit privy	12 Fertilizer storage	cont. site	3 Watertight sewer lines	8 Sewage lagoon	13 Insecticide storage		4 Lateral lines	9 Feedyard	14 Abandoned water well		5 Cess pool	10 Livestock pens	15 Oil well/Gas well	
1 Septic tank	6 Seepage pit	11 Fuel storage	16 Other (specify below)																			
2 Sewer lines	7 Pit privy	12 Fertilizer storage	cont. site																			
3 Watertight sewer lines	8 Sewage lagoon	13 Insecticide storage																				
4 Lateral lines	9 Feedyard	14 Abandoned water well																				
5 Cess pool	10 Livestock pens	15 Oil well/Gas well																				
Direction from well? How many feet?																						

FROM	TO	PLUGGING MATERIALS
17	.5	Bentonite
.5	0	Concrete

7	CONTRACTOR'S OF LANDOWNER'S CERTIFICATION: This water well was plugged under my jurisdiction and was completed on (mo/day/year) 03/29/06 and this record is true to the best of my knowledge and belief. Kansas Water Well Contractor's License No. 585 This Water Well Record was completed on (mo/day/year) 04/20/06 under the business name of Associated Environmental, Inc. by (signature) Bradley J. Johnson	
---	---	--

INSTRUCTIONS: Use typewriter or ball point pen. Please press firmly and print clearly. Please fill in blanks, underline or circle the correct answers. Send top three copies to Kansas Department of Health and Environment, Bureau of Water, Geology Section, 1000 SW Jackson St., Ste. 420, Topeka, Kansas 66612-1367. Telephone: 785/296-5522. Send one to Water Well Owner and retain one for your records.