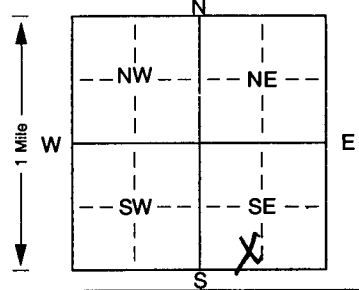


1 LOCATION OF WATER WELL:		Fraction	Section Number	Township Number	Range Number
County: Wyandotte		SE 1/4 SE 1/4 SE 1/4	18	T 11 S	R 25 EW
Distance and direction from nearest town or city street address of well if located within city? 3601 Fairbanks Ave KCKs 800' SW					
2 WATER WELL OWNER: SPX Corp. 28277 RR#, St. Address, Box # : 13535 Ballantyne Corp. Place City, State, ZIP Code : Charlotte N. Carolina Board of Agriculture, Division of Water Resources Application Number:					
3 LOCATE WELL'S LOCATION WITH AN "X" IN SECTION BOX:		4 DEPTH OF COMPLETED WELL: 70 ft. ELEVATION: 750.92			
		Depth(s) Groundwater Encountered 1. 34 ft. 2. ft. 3. ft.			
		WELL'S STATIC WATER LEVEL 29.7 ft. below land surface measured on mo/day/yr 10/18/05			
		Pump test data: Well water was ft. after hours pumping gpm			
		Est. Yield gpm: Well water was ft. after hours pumping gpm			
		Bore Hole Diameter 8 1/4 in. to 7 1/2 ft., and in. to ft.			
		WELL WATER TO BE USED AS: 5 Public water supply 8 Air conditioning 11 Injection well 1 Domestic 3 Feedlot 6 Oil field water supply 9 Dewatering 12 Other (Specify below) 2 Irrigation 4 Industrial 7 Domestic (lawn & garden) 10 Monitoring well			
		Was a chemical/bacteriological sample submitted to Department? Yes. (No); If yes, mo/day/yr sample was submitted			
		Water Well Disinfected? Yes (No)			
5 TYPE OF BLANK CASING USED: 1 Steel 3 RMP (SR) 5 Wrought iron 8 Concrete tile CASING JOINTS: Glued. Clamped. 2 PVC 4 ABS 6 Asbestos-Cement 9 Other (specify below) Welded Blank casing diameter 2 in. to 59.5 ft., Dia in. to ft., Dia in. to ft. Casing height above land surface 30 in., weight lbs./ft. Wall thickness or gauge No. TYPE OF SCREEN OR PERFORATION MATERIAL: 1 Steel 3 Stainless steel 5 Fiberglass 7 PVC 10 Asbestos-cement 2 Brass 4 Galvanized steel 6 Concrete tile 8 RMP (SR) 11 Other (specify) SCREEN OR PERFORATION OPENINGS ARE: 1 Continuous slot 3 Mill slot 5 Gauzed wrapped 8 Saw cut 11 None (open hole) 2 Louvered shutter 4 Key punched 6 Wire wrapped 9 Drilled holes SCREEN-PERFORATED INTERVALS: From 59.5 ft. to 69.5 ft., From ft. to ft. GRAVEL PACK INTERVALS: From 70.0 ft. to 56.0 ft., From ft. to ft. From ft. to ft., From ft. to ft.					
6 GROUT MATERIAL: 1 Neat cement 2 Cement grout 3 Bentonite 4 Other Grout Intervals: From 54 ft. to 2 ft., From ft. to ft., From ft. to ft. What is the nearest source of possible contamination: 1 Septic tank 4 Lateral lines 7 Pit privy 10 Livestock pens 14 Abandoned water well 2 Sewer lines 5 Cess pool 8 Sewage lagoon 11 Fuel storage 15 Oil well/Gas well 3 Watertight sewer lines 6 Seepage pit 9 Feedyard 12 Fertilizer storage 16 Other (specify below) Direction from well? East How many feet? 800					
FROM	TO	LITHOLOGIC LOG	FROM	TO	PLUGGING INTERVALS
0.0	2.5	asphalt-clay fill			
2.5	29.0	brn clay silt			
29.0	50.5	brn fine silty sand			
50.5	64.0	brn fine-med sand			
64.0	69.0	med-course sand			
69.0	71.5	L.S.			
71.5	74.0	grn gry shale			
7 CONTRACTOR'S OR LANDOWNER'S CERTIFICATION: This water well was (1) constructed, (2) reconstructed, or (3) plugged under my jurisdiction and was completed on (mo/day/year) 10-6-05 and this record is true to the best of my knowledge and belief. Kansas Water Well Contractor's Licence No. 614 This Water Well Record was completed on (mo/day/yr) 10/31/05 under the business name of Maxim by (signature) William Stefford					