


1 LOCATION OF WATER WELL: Fraction NW 1/4 SE 1/4 SW 1/4 Section Number 5 Township Number T11S Range Number R25E  
 County: WYANDOTTE

Distance and direction from nearest town or city street address of well if located within city?  
2859 STATE AVENUE KANSAS CITY, KS

2 WATER WELL OWNER: BP/AMOCO  
 RR #, St. Address, Box #: 2859 STATE AVENUE Board of Agriculture, Division of Water Resources  
 City, State, ZIP Code: KANSAS CITY, KS Application Number:

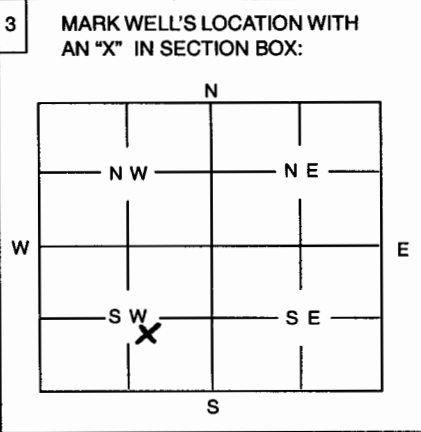

4 DEPTH OF WELL 20.04 ft  
 WELL'S STATIC WATER LEVEL 19.19 ft  
 WELL WAS USED AS:  
 1 Domestic 5 Public Water Supply 9 Dewatering  
 2 Irrigation 6 Oil Field Water Supply 10 Monitoring Well  
 3 Feedlot 7 Domestic (Lawn & Garden) 11 Injection Well  
 4 Industrial 8 Air Conditioning 12 Other .....

Was a chemical / bacteriological sample submitted to Department? Yes ..... No X.....  
 If yes, mo/day/yr sample was submitted .....

Water Well Disinfected: Yes ..... No X.....

5 TYPE OF BLANK CASING USED:  
 1 Steel 3 RMP (SR) 5 Wrought 7 Fiberglass 9 Other (Specify below)  
2 PVC 4 ABS 6 Asbestos-Cement 8 Concrete Tile .....

Blank casing diameter 2 in. Was casing pulled? Yes X No ..... If yes, how much all .....

6 GROUT PLUG MATERIAL: 1 Neat cement 2 Cement grout 3 Bentonite 4 Other .....

Grout Plug Intervals: From 20 ft. to 0 ft., From ..... ft. to ..... ft., From ..... to ..... ft.

What is the nearest source of possible contamination:  
 1 Septic tank 6 Seepage pit 11 Fuel storage USTs 16 Other (specify below)  
 2 Sewer lines 7 Pit privy 12 Fertilizer storage  
 3 Watertight sewer lines 8 Sewage lagoon 13 Insecticide storage  
 4 Lateral lines 9 Feedyard 14 Abandoned water well  
 5 Cess Pool 10 Livestock pens 15 Oil well/Gas well

Direction from well? SOUTH How many feet? 255

FROM	TO	PLUGGING MATERIALS
<u>20ft</u>	<u>0 ft</u>	<u>BENTONITE CHIPS (HYDRATED)</u>

7 CONTRACTOR'S OR LANDOWNER'S CERTIFICATION: This water well was plugged under my jurisdiction and was completed on (mo/day/year) 6/30/06 and this record is true to the best of my knowledge and belief. Kansas Water Well Contractor's License No. 707 This Water Well Record was completed on (mo/day/year) ..... under the business name of MAX S by (signature) David Hinkle

INSTRUCTIONS: Use typewriter or ball point pen. Please press firmly and print clearly. Please fill in blanks, underline or circle the correct answers. Send top three copies to Kansas Department of Health and Environment, Bureau of Water, Topeka, Kansas 66620-0001. Telephone: 785/296-3565. Send one to Water Well Owner and retain one for your records.