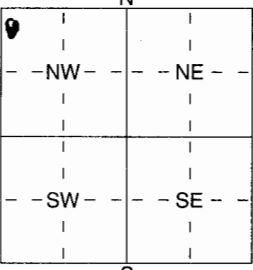


1 LOCATION OF WATER WELL: County: <u>Wyandotte</u>	Fraction <u>NW 1/4 NW 1/4 NW 1/4</u>	Section Number <u>21</u>	Township Number <u>T 11 S</u>	Range Number <u>R 25 E</u>
---	---	-----------------------------	----------------------------------	-------------------------------

Distance and direction from nearest town or city street address of well if located within city?

2 WATER WELL OWNER: <u>Colgate Palmolive Company</u> RR#, St. Address, Box # : <u>1806 Kansas Ave</u> City, State, ZIP Code : <u>Kansas City, KS</u>	Board of Agriculture, Division of Water Resources Application Number:
--	--


3 LOCATE WELL'S LOCATION WITH AN "X" IN SECTION BOX: 	4 DEPTH OF COMPLETED WELL <u>42'</u> ft. ELEVATION: <u>39</u> ft. Depth(s) Groundwater Encountered 1 <u>39</u> ft. 2 ft. 3 ft. WELL'S STATIC WATER LEVEL ft. below land surface measured on mo/day/yr Pump test data: Well water was ft. after hours pumping gpm Est. Yield gpm: Well water was ft. after hours pumping gpm WELL WATER TO BE USED AS: 1 Domestic 3 Feedlot 5 Public water supply 8 Air conditioning <u>11 Injection well</u> 2 Irrigation 4 Industrial 7 Domestic (lawn & garden) 9 Dewatering 12 Other (Specify below) 10 Monitoring well Was a chemical/bacteriological sample submitted to Department? Yes No <u>X</u> ; If yes, mo/day/yr sample was submitted Water Well Disinfected? Yes No <u>X</u>
---	--

5 TYPE OF BLANK CASING USED: 1 Steel 3 RMP (SR) 5 Wrought iron 8 Concrete tile CASING JOINTS: Glued Clamped <u>2 PVC</u> 4 ABS 6 Asbestos-Cement 9 Other (specify below) <u>Welded</u> Blank casing diameter <u>1.25</u> in. to <u>42</u> ft. Dia <u>sch 80</u> in. to ft. Dia <u>Threaded</u> in. to ft. Casing height above land surface <u>0</u> in., weight <u>sch 80</u> lbs./ft. Wall thickness or gauge No. <u>sch 30</u> TYPE OF SCREEN OR PERFORATION MATERIAL: 1 Steel 3 Stainless Steel 5 Fiberglass 8 RMP (SR) 10 Asbestos-Cement 2 Brass 4 Galvanized Steel 6 Concrete tile 9 ABS 11 Other (Specify) 12 None used (open hole) SCREEN OR PERFORATION OPENINGS ARE: 1 Continuous slot 3 Mill slot 5 Gauzed wrapped 8 Saw cut 11 None (open hole) 2 Louvered shutter 4 Key punched 6 Wire wrapped 9 Drilled holes 3 Torch cut 10 Other (specify) ft. SCREEN-PERFORATED INTERVALS: From <u>34</u> ft. to <u>42</u> ft. From ft. to ft. GRAVEL PACK INTERVALS: From <u>33</u> ft. to <u>42</u> ft. From ft. to ft.
--

6 GROUT MATERIAL: 1 Neat cement 2 Cement grout 3 Bentonite 4 Other Grout Intervals: From <u>1</u> ft. to <u>33</u> ft. From ft. to ft. From ft. to ft. What is the nearest source of possible contamination: 1 Septic tank 4 Lateral lines 7 Pit privy 10 Livestock pens 14 Abandoned water well 2 Sewer lines 5 Cess pool 8 Sewage lagoon 11 Fuel storage 15 Oil well/Gas well 3 Watertight sewer lines 6 Seepage pit 9 Feedyard 12 Fertilizer storage 16 Other (specify below) 13 Insecticide storage Direction from well? How many feet?
--

FROM	TO	LITHOLOGIC LOG	FROM	TO	PLUGGING INTERVALS
			<u>0</u>	<u>1</u>	<u>Concrete</u>
			<u>1</u>	<u>33</u>	<u>Cement/Bentonite grout</u>
			<u>33</u>	<u>42</u>	<u>Sand pack</u>
<p>Well was filled with cement grout to the surface, cut of ~3' BGS</p>					

7 CONTRACTOR'S OR LANDOWNER'S CERTIFICATION: This water well was (1) constructed, (2) reconstructed, or (3) plugged under my jurisdiction and was completed on (mo/day/year) <u>9-14-06</u> and this record is true to the best of my knowledge and belief. Kansas Water Well Contractor's Licence No. <u>759</u> This Water Well Record was completed on (mo/day/yr) <u>9-17-06</u> under the business name of <u>RAZEK Environmental, LLC</u> by (signature) <u>[Signature]</u>
--

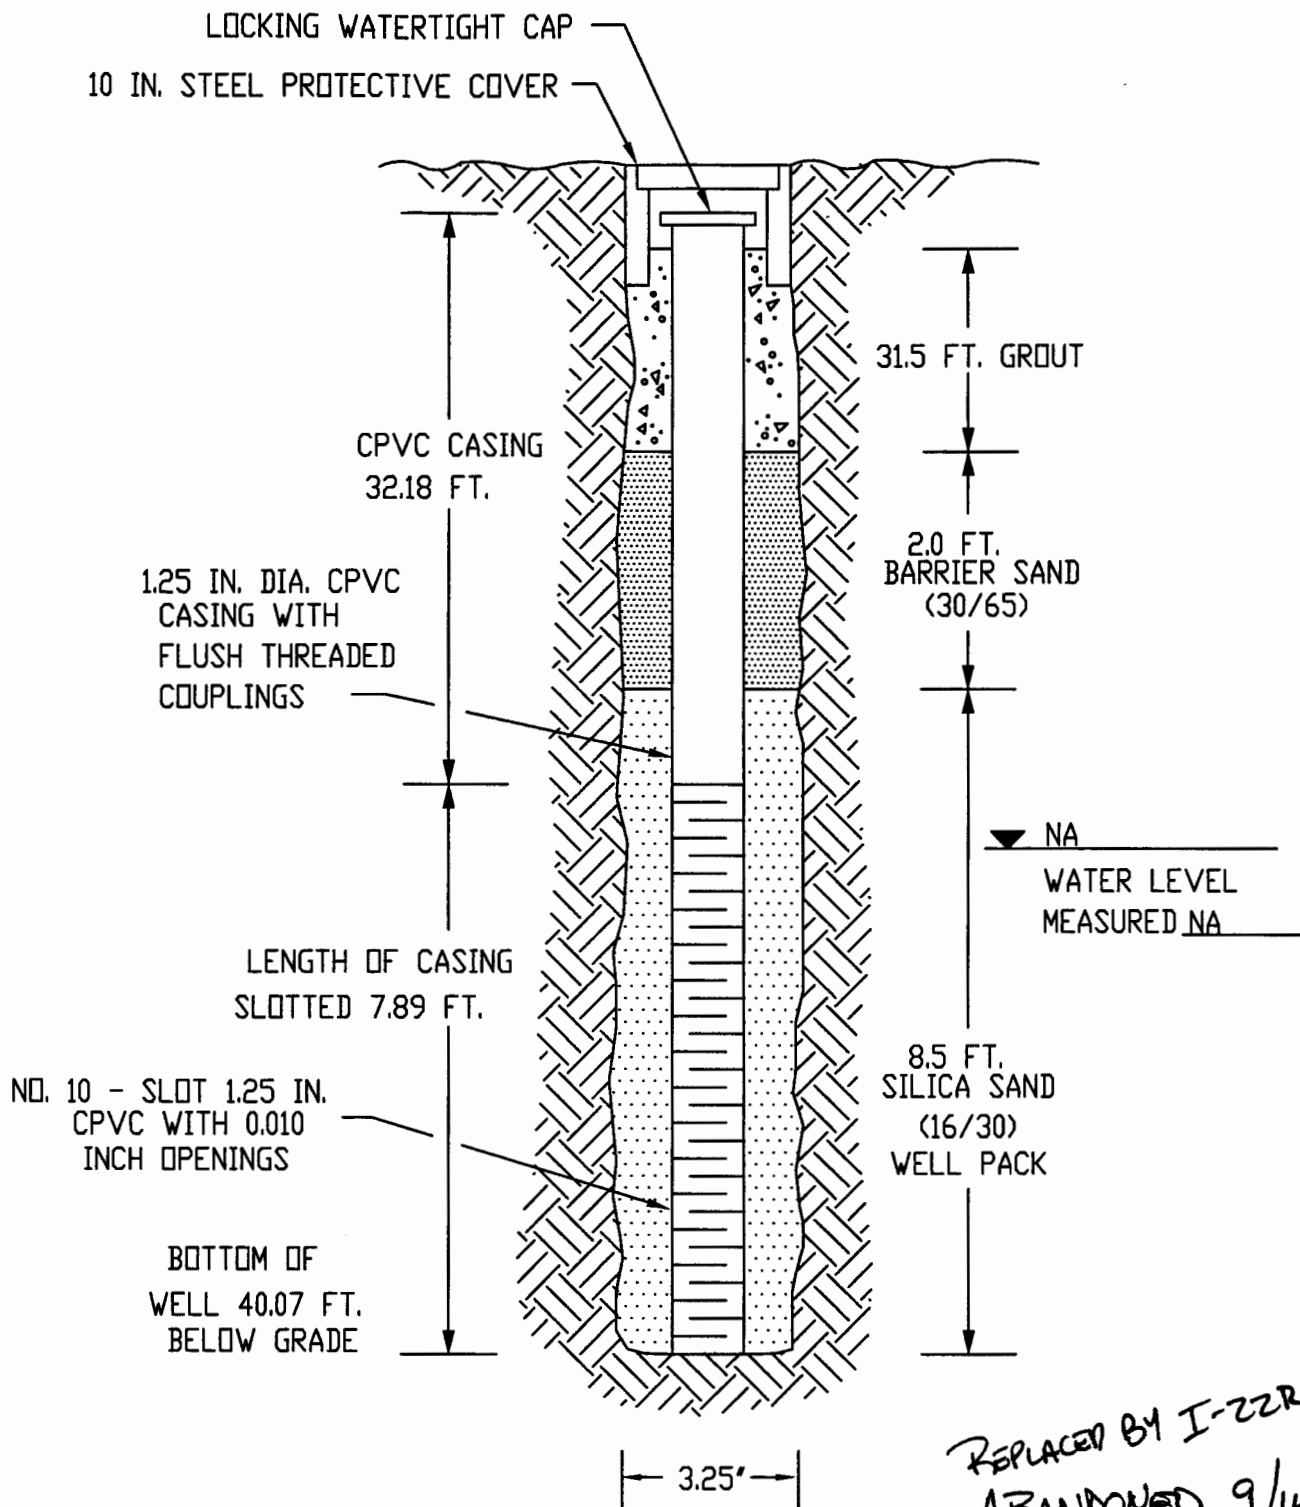

REPLACED BY I-22RC
 ABANDONED 9/14/06
 DATE INSTALLED 8/28/06

NOT TO SCALE



MONITORING WELL I-22C
 MONITORING WELL
 CONSTRUCTION DIAGRAM
 COLGATE PALMOLIVE
 RAILCAR UNLOADING AREA
 KANSAS CITY, KANSAS



FACILITY ENTRANCE

OSAGE AVENUE

STORM
WATER
RETENTION
BASIN

FENCE

LEGEND

- MONITORING WELL
- INJECTION WELLS
- INJECTION WELLS



SITE MAP
COLGATE PALMOLIVE
RAIL CAR UNLOADING AREA
KANSAS CITY, KANSAS