WATER WELL RECORD Form WWC-5 KSA 82a-1212 ID No. MW-8

1 LOCATION OF WATER WELL: County: ~~Johnson~~ WYANDOTTE | Fraction: NE SE NW | Section Number: 22 | Township Number: 11 T (S) | Range Number: R 25 (E) W

Distance and direction from nearest town or city street address of well if located within city? 500 Osage St. Kansas City, KS 66105

2 WATER WELL OWNER: Graham Truckings
RR#, St. Address, Box # : 500 Osage St.
City, State, ZIP Code : Kansas City, KS 66105
Board of Agriculture, Division of Water Resources Application Number:

3 LOCATE WELL'S LOCATION WITH AN "X" IN SECTION BOX:

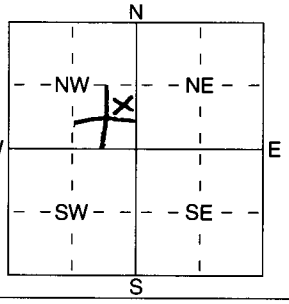

4 DEPTH OF COMPLETED WELL 35.0 ft. ELEVATION:
Depth(s) Groundwater Encountered 1 ..... ft. 2 ..... ft. 3 ..... ft.
WELL'S STATIC WATER LEVEL 25.65 ft. below land surface measured on mo/day/yr .....
Pump test data: Well water was ..... ft. after ..... hours pumping ..... gpm
Est. Yield ..... gpm: Well water was ..... ft. after ..... hours pumping ..... gpm
WELL WATER TO BE USED AS: 1 Domestic 2 Irrigation 3 Feedlot 4 Industrial 5 Public water supply 6 Oil field water supply 7 Domestic (lawn & garden) 8 Air conditioning 9 Dewatering (10) Monitoring well 11 Injection well 12 Other (Specify below)
Was a chemical/bacteriological sample submitted to Department? Yes ..... No X; If yes, mo/day/yrs sample was submitted
Water Well Disinfected? Yes (No)

5 TYPE OF BLANK CASING USED: 1 Steel 2 (PVC) 3 RMP (SR) 4 ABS 5 Wrought iron 6 Asbestos-Cement 7 Fiberglass 8 Concrete tile 9 Other (specify below)
CASING JOINTS: Glued ..... Clamped ..... Welded ..... (Threaded)
Blank casing diameter 2" in. to 15' ft., Dia ..... in. to ..... ft., Dia ..... in. to ..... ft.
Casing height above land surface Flush in., weight ..... lbs./ft. Wall thickness or guage No. Sch. 40
TYPE OF SCREEN OR PERFORATION MATERIAL: 1 Steel 2 Brass 3 Stainless Steel 4 Galvanized Steel 5 Fiberglass 6 Concrete tile (7) PVC 8 RMP (SR) 9 ABS 10 Asbestos-Cement 11 Other (Specify) ..... 12 None used (open hole)
SCREEN OR PERFORATION OPENINGS ARE: 1 Continuous slot 2 Louvered shutter (3) Mill slot 4 Key punched 5 Guazed wrapped 6 Wire wrapped 7 Torch cut 8 Saw cut 9 Drilled holes 10 Other (specify) ..... 11 None (open hole)
SCREEN-PERFORATED INTERVALS: From 15' ft. to 35' ft., From ..... ft. to ..... ft.
From ..... ft. to ..... ft., From ..... ft. to ..... ft.
GRAVEL PACK INTERVALS: From 13' ft. to 35' ft., From ..... ft. to ..... ft.
From ..... ft. to ..... ft., From ..... ft. to ..... ft.

6 GROUT MATERIAL: 1 Neat cement 2 Cement grout (3) Bentonite 4 Other .....
Grout Intervals: From 1 ft. to 13' ft., From ..... ft. to ..... ft., From ..... ft. to ..... ft.
What is the nearest source of possible contamination:
1 Septic tank 2 Sewer lines 3 Watertight sewer lines 4 Lateral lines 5 Cess pool 6 Seepage pit 7 Pit privy 8 Sewage lagoon 9 Feedyard 10 Livestock pens 11 Fuel storage 12 Fertilizer storage 13 Insecticide storage 14 Abandoned water well 15 Oil well/Gas well 16 Other (specify below) .....
Direction from well? How many feet?

FROM	TO	LITHOLOGIC LOG	FROM	TO	PLUGGING INTERVALS
		See Boring Log			

7 CONTRACTOR'S OR LANDOWNER'S CERTIFICATION: This water well was (1) constructed, (2) reconstructed, or (3) plugged under my jurisdiction and was completed on (mo/day/year) 10-5-06 and this record is true to the best of my knowledge and belief. Kansas Water Well Contractor's Licence No 606 This Water Well Record was completed on (mo/day/yr) 11-21-06 under the business name of PSA Environmental by (signature)

INSTRUCTIONS: Use typewriter or ball point pen. *PLEASE PRESS FIRMLY* and *PRINT* clearly. Please fill in blanks, underline or circle the correct answers. Send top three copies to Kansas Department of Health and Environment, Bureau of Water, Geology Section, 1000 SW Jackson St., Suite 420, Topeka, Kansas 66612-1367. Telephone 785-296-5522. Send one to WATER WELL OWNER and retain one for your records. Fee of $5.00 for each constructed well.

PROJECT: NAME: Lancaster

MONITORING WELL/BORING NO. MW-8

LOCATION:

DRILL EQUIPMENT: Geoprobe

DRILLING METHOD: SSA

DRILLED BY: Aaron OFFICE: PSA

LOGGED BY: Brad H OFFICE: IT

REMARKS: Logged by Cuttings

TOP OF HOLE ELEV. (ft):

GROUNDWATER ELEV. (DATE) (ft):

STARTED: DATE: 10/2/06 TIME: 1230

COMPLETED: DATE: 10/2/06 TIME: 1400

DEPTH (ft)	LEGEND	CLASSIFICATION AND DESCRIPTION	SAMPLE SYMBOL	PENET. RESIST. (BLOWS/ft)	FIELD SCREENING RESULTS: HNU (PID) HEADSPACE	OVA (FID) HEADSPACE	ODOR	STAINING
0.0		DK Brown Silty Clay			NA			
5.0		Brown Silty Clay						
10.0		Gray Brown Clay w/ some Silt						
15.0		Gray Brown Clay w/ some Silt						
20.0		Gray Brown Clay w/ some Silt						
25.0								
30.0								
35.0								

CAL = CALIFORNIA
SS = SPLIT SPOON
ST = SHELBY TUBE
DB = DISTURBED BULK /GRAB SAMPLE

CON = CONTINUOUS SAMPLE
CORE = CORE SAMPLE
CA = SAMPLE SUBMITTED FOR CHEMICAL ANALYSIS
"-" = NOT ANALYZED

NS = NO SHEEN
SS = SLIGHT SHEEN
MS = MODERATE SHEEN
HS = HEAVY SHEEN

DEPTH TO BOTTOM OF BORING 25.0'

PROJECT NO.

MAXIM TECHNOLOGIES INC

FIELD LOG OF EXPLORATORY BORING NO. MW-8

SHEET 1 OF 1