

County: Wyandotte Fraction: SW SE NW NW Sec. 21 T. 11 S R. 25 E

**CORRECTION(S) to WATER WELL COMPLETION RECORD Form WWC-5 (to rectify lacking or incorrect information)**

Owner: Colgate-Palmolive I 48 C

If location corrected, was listed as:

Location changed to:

Section-Township-Range: \_\_\_\_\_

\_\_\_\_\_

Fraction (¼ calls): NW NW NW

SW SE NW NW

Other changes: Initial statements: Latitude and Longitude taken from plugging record


Changed to: Latitude 39.084659 Longitude -94.646185

Comments: \_\_\_\_\_

Verification method: Verified with LEOWEB and KGS mapper

\_\_\_\_\_ Initials: SH Date: 04-16-2019

Submitted by: ☒ Kansas Geological Survey, Data Resources Library, 1930 Constant Ave., Lawrence, KS 66047-3724  
☐ Kansas Dept. of Health & Environment, Bureau of Water, 1000 SW Jackson, Suite 420, Topeka, KS 66612-1367

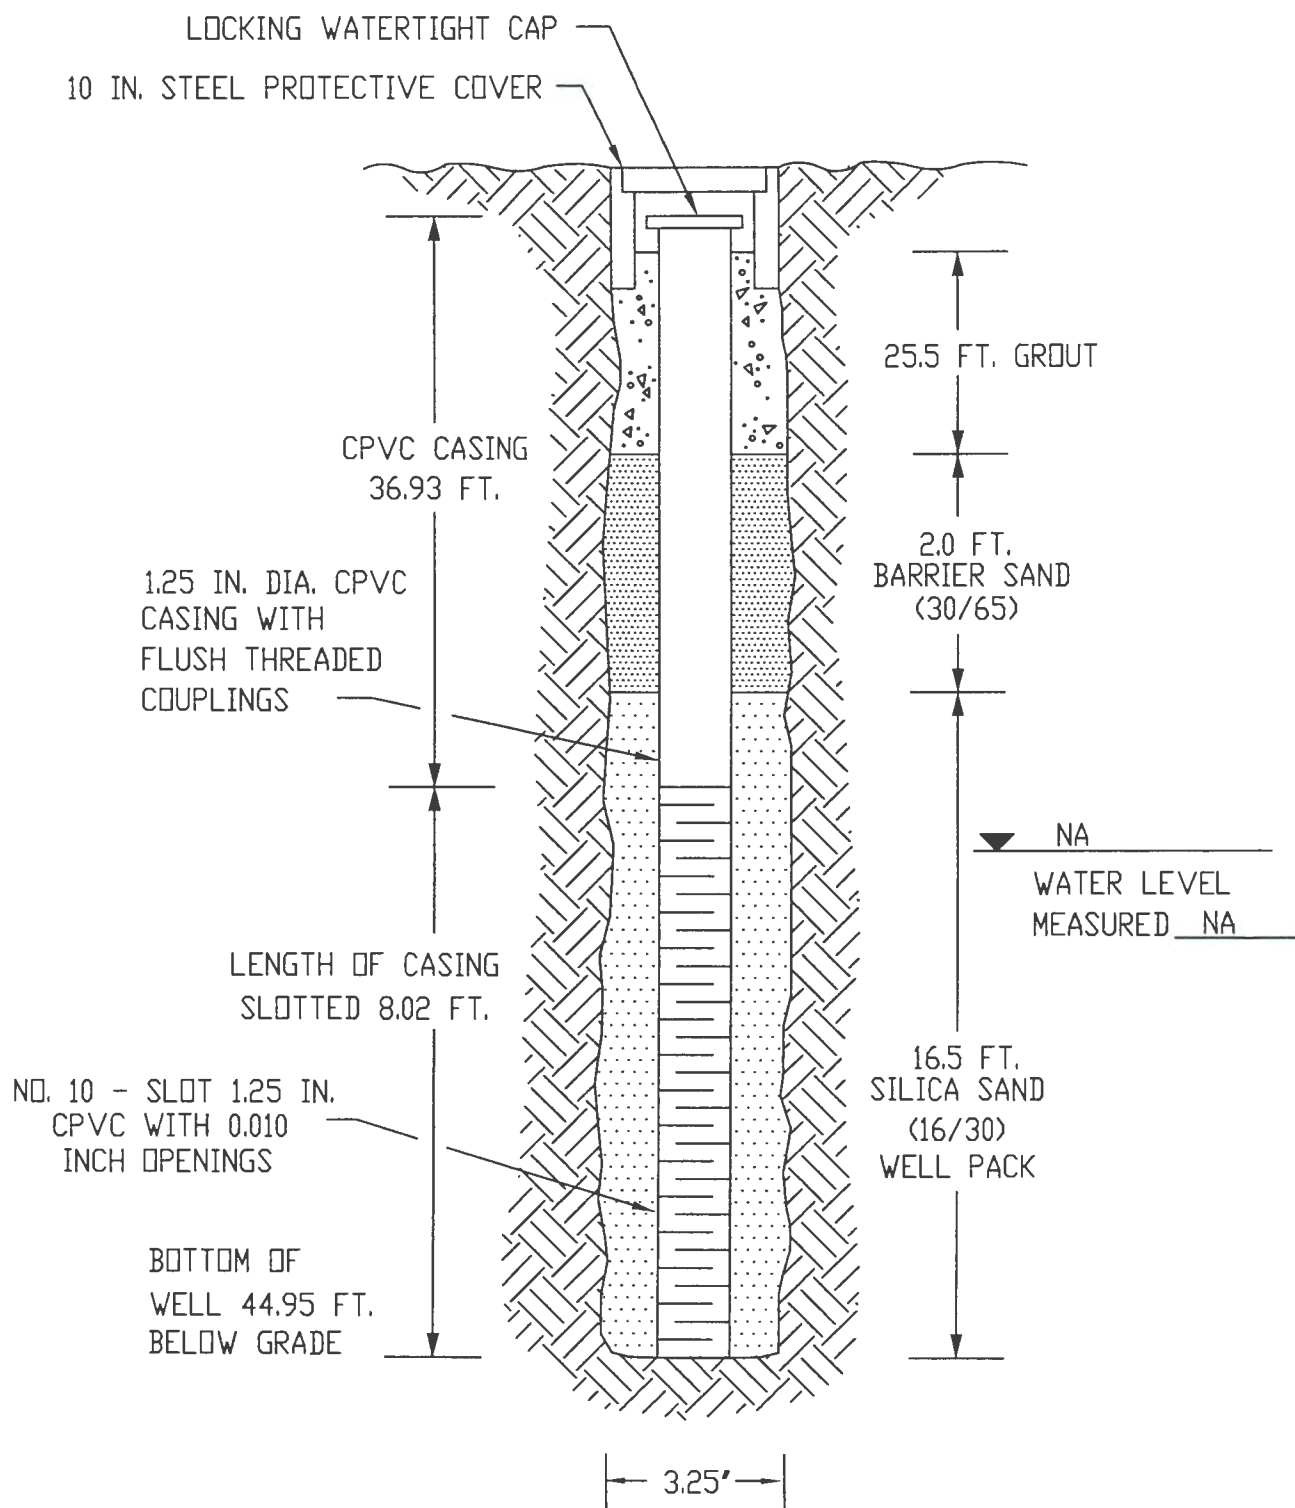

NOT TO SCALE

DATE INSTALLED 11/21/06



MONITORING WELL I-48C  
MONITORING WELL  
CONSTRUCTION DIAGRAM  
COLGATE PALMOLIVE  
RAILCAR UNLOADING AREA  
KANSAS CITY, KANSAS

INSTRUCTIONS: Use typewriter or ballpoint pen. PLEASE PRESS FIRMLY and PRINT clearly. Please fill in blanks, underline or circle the correct answers. Send top three copies to Kansas Department of Health and Environment, Bureau of Water, Geology Section, 1000 SW Jackson St., Suite 420, Topeka, Kansas 66612-1367. Telephone 785-296-5522. Send ONE COPY TO EACH WATER USER and retain one for your records. Fee of \$5.00 for each constructed well.