

KSA 82a-1212

Drilling Log

Project Name BUNGE-KATY		Project Number		Boring Number DPVE-3	
Ground Elevation		Location KATY ELEVATOR KCK		Page 1	
Air Monitoring Equipment PID/LEL/OL				Total Footage 30	
Drilling Type HSA	Hole Size 8 1/4"	Overburden Footage 29.5	Bedrock Footage 0.5	No. of Samples —	No. of Core Boxes —
Drilling Company RAZER			Driller(s) TONY POULTER, SCOTT FARRU		
Drilling Rig GEOPROBE 6620 DT			Type of Sampler LOG FROM CUTTINGS		
Date 4/25/07		To 9/25/07		Field Observer(s) RUTH PARKHURST	

Depth (feet)	Description	Class	Blow Count	Recov.	Run/Time	Sample Desig.	PID (ppm)			Remarks/ Water Levels
							BZ	BH	S	
1	CLAY, with silt and sand, fill material gravels. very dark grayish brown to black (10R 3/2) to (10R 2/1), medium plasticity, medium consistency	CL			1550					
2										
3										
4										
5										
6					1601					3.4
7	SAND, very dark grayish brown (10R 3/2), moist, poorly graded, medium grained to coarse									
8										
9										
10										
11					1606					1125
12										
13										
14										

BZ=Breathing Zone

BH=Bore Hole

S=Sample



051601 Form WCD-2-1


Drilling Log Continuation

Project Name BENGE-KATY						Boring Number DPVE-3				
Project Number						Page 2 of				
						Date 9/25/07				
Depth (feet)	Description	Class	Blow Count	Recov.	Run/ Time	Sample Desig.	PID (ppm)			Remarks/ Water Levels
							BZ	BH	S	
15	strong dur. wily residue				1616				687	
16										
17										
18										
19										
20					1614				1447	
21										
22	NO CUTTINGS - CLAY?									NO CUTTINGS CLAY?
23										
24										
25					1615				220	
26										
27										
28										
29	hard drilling: gravel/ weathered bedrock?									
30	LIMESTONE	LS			1025					
	Refusal @ 30'									


BZ=Breathing Zone

BH=Bore Hole

S=Sample

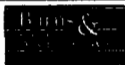

051601 Form WCD-KC-2-2

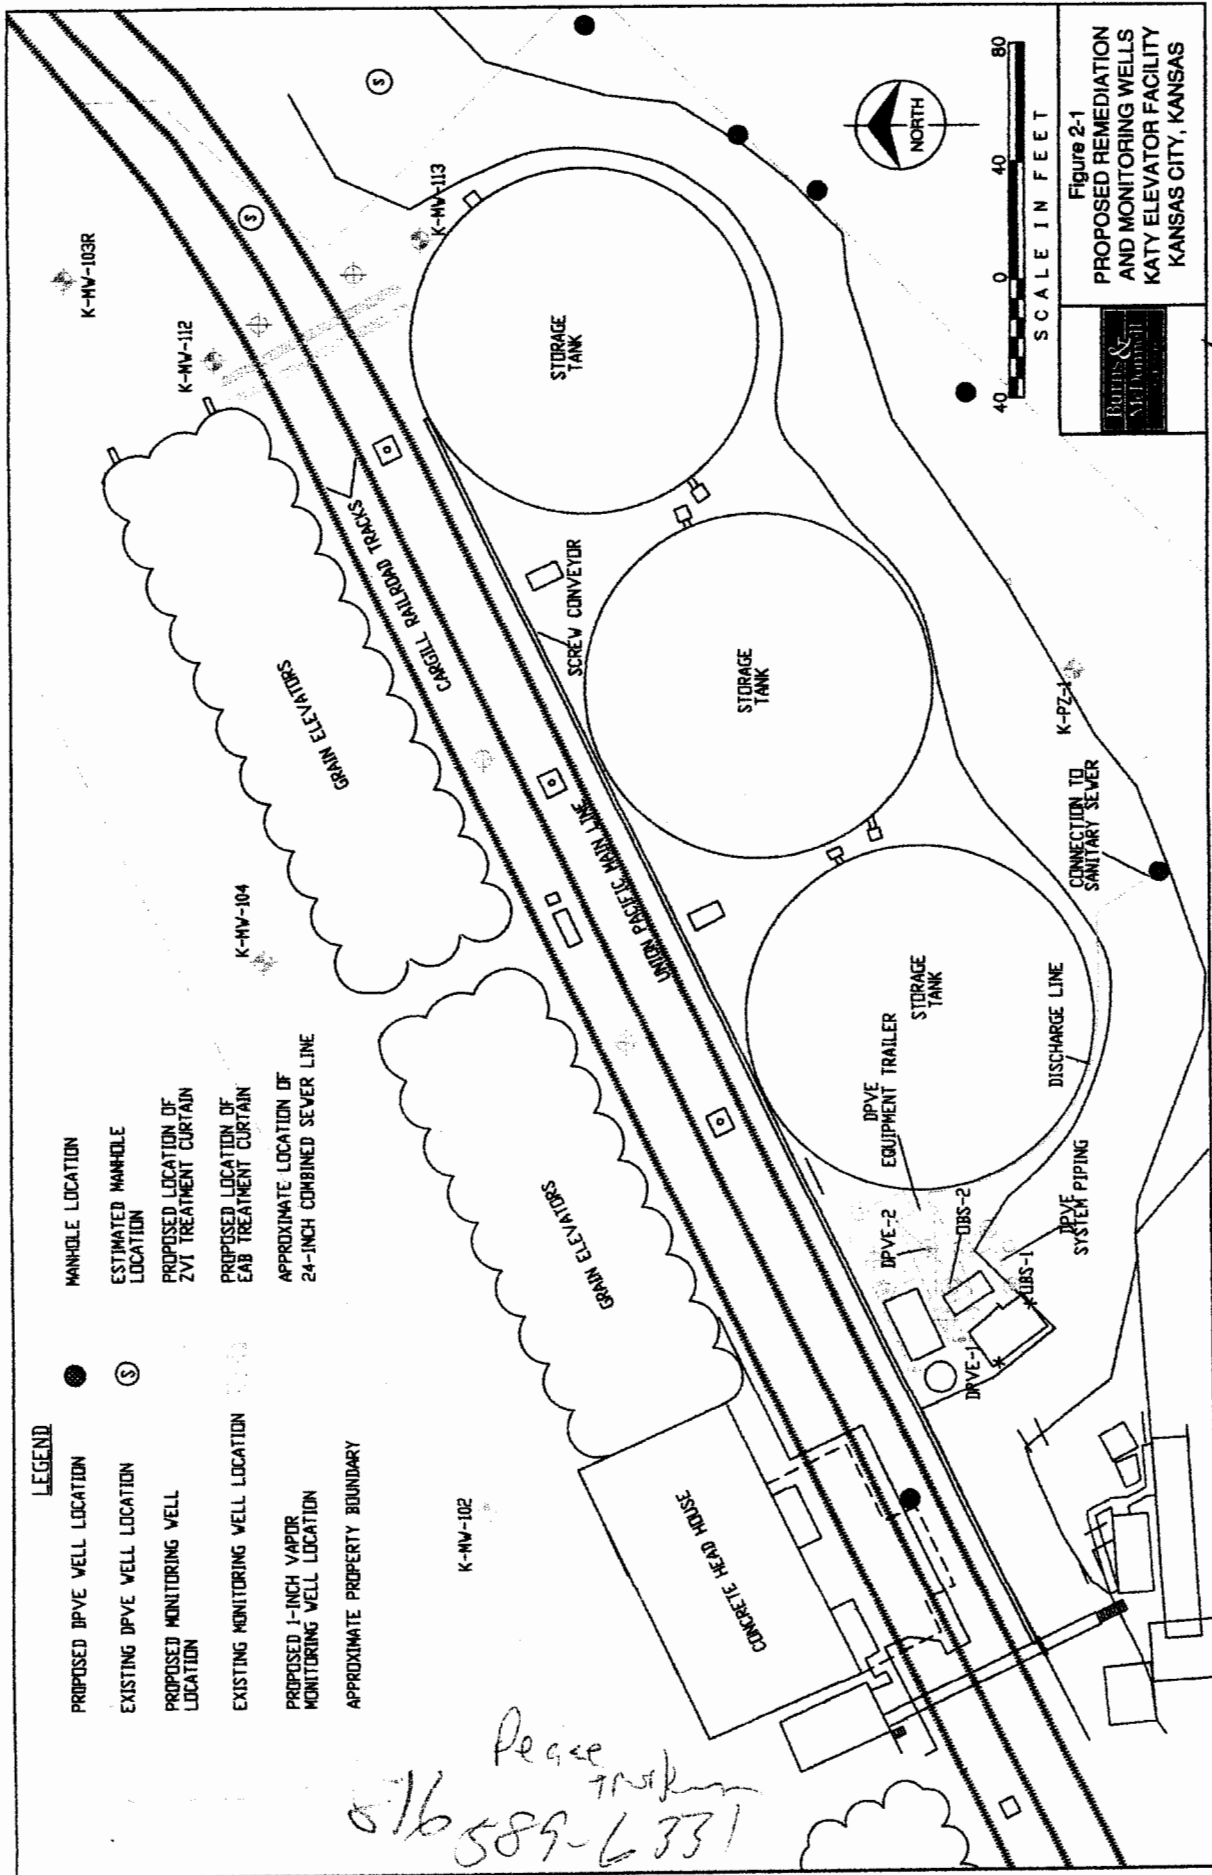

N39 04.159 Elev. 542
W094 36.788 Wyandotte County