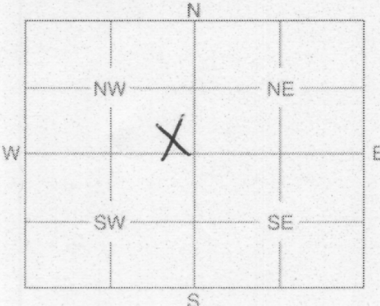
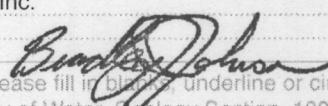


1	LOCATION OF WATER WELL: Wyandotte	Fraction SE $\frac{1}{4}$ SE $\frac{1}{4}$ NW $\frac{1}{4}$	Section Number 33	Township Number 11S	Range Number R25E																								
County: Wyandotte																													
Distance and direction from nearest town or city street address of well if located within city? 2727 Roe Lane, Kansas City Kansas																													
2	WATER WELL OWNER: Unimark Oil RR #, St. Address, Box #: P.O. Box 1913 City, State, ZIP Code: El Dorado, AR 71731		Board of Agriculture, Division of Water Resources Application Number:																										
3	MARK WELL'S LOCATION WITH AN "X" IN SECTION BOX: 		4 DEPTH OF WELL 11.12 ft. WELL'S STATIC WATER LEVEL 60 ft. WELL WAS USED AS: <table border="0"><tr><td>1 Domestic</td><td>5 Public Water Supply</td><td>9 Dewatering</td></tr><tr><td>2 Irrigation</td><td>6 Oil Field Water Supply</td><td>10 Monitoring Well</td></tr><tr><td>3 Feedlot</td><td>7 Domestic (Lawn & Garden)</td><td>11 Injection Well</td></tr><tr><td>4 Industrial</td><td>8 Air Conditioning</td><td>12 Other</td></tr></table> Was a chemical / bacteriological sample submitted to Department? Yes No X If yes, mo/day/yr sample was submitted Water Well Disinfected: Yes No X			1 Domestic	5 Public Water Supply	9 Dewatering	2 Irrigation	6 Oil Field Water Supply	10 Monitoring Well	3 Feedlot	7 Domestic (Lawn & Garden)	11 Injection Well	4 Industrial	8 Air Conditioning	12 Other												
1 Domestic	5 Public Water Supply	9 Dewatering																											
2 Irrigation	6 Oil Field Water Supply	10 Monitoring Well																											
3 Feedlot	7 Domestic (Lawn & Garden)	11 Injection Well																											
4 Industrial	8 Air Conditioning	12 Other																											
5	TYPE OF BLANK CASING USED: <table border="0"><tr><td>1 Steel</td><td>3 RMP (SR)</td><td>5 Wrought</td><td>7 Fiberglass</td><td>9 Other (Specify below)</td></tr><tr><td>2 PVC</td><td>4 ABS</td><td>6 Asbestos-Cement</td><td>8 Concrete Tile</td><td></td></tr></table> Blank casing diameter 2 in. Was casing pulled? Yes X No If yes, how much all Casing height above or below land surface in.		1 Steel	3 RMP (SR)	5 Wrought	7 Fiberglass	9 Other (Specify below)	2 PVC	4 ABS	6 Asbestos-Cement	8 Concrete Tile																		
1 Steel	3 RMP (SR)	5 Wrought	7 Fiberglass	9 Other (Specify below)																									
2 PVC	4 ABS	6 Asbestos-Cement	8 Concrete Tile																										
6	GROUT PLUG MATERIAL: 3 1 Neat cement 2 Cement grout Grout Plug Intervals: From 11.12 ft. to 1 ft. What is the nearest source of possible contamination: <table border="0"><tr><td>1 Septic tank</td><td>6 Seepage pit</td></tr><tr><td>2 Sewer lines</td><td>7 Pit privy</td></tr><tr><td>3 Watertight sewer lines</td><td>8 Sewage lagoon</td></tr><tr><td>4 Lateral lines</td><td>9 Feedyard</td></tr><tr><td>5 Cess pool</td><td>10 Livestock pens</td></tr></table> Direction from well? How many feet?		1 Septic tank	6 Seepage pit	2 Sewer lines	7 Pit privy	3 Watertight sewer lines	8 Sewage lagoon	4 Lateral lines	9 Feedyard	5 Cess pool	10 Livestock pens	3 Bentonite 4 Other Concrete From 1 ft. to 0 ft. From to ft. <table border="0"><tr><td>11 Fuel storage</td><td>15 Other (specify below)</td></tr><tr><td>12 Fertilizer storage</td><td>cont. site</td></tr><tr><td>13 Insecticide storage</td><td></td></tr><tr><td>14 Abandoned water well</td><td></td></tr><tr><td>15 Oil well/Gas well</td><td></td></tr></table>			11 Fuel storage	15 Other (specify below)	12 Fertilizer storage	cont. site	13 Insecticide storage		14 Abandoned water well		15 Oil well/Gas well					
1 Septic tank	6 Seepage pit																												
2 Sewer lines	7 Pit privy																												
3 Watertight sewer lines	8 Sewage lagoon																												
4 Lateral lines	9 Feedyard																												
5 Cess pool	10 Livestock pens																												
11 Fuel storage	15 Other (specify below)																												
12 Fertilizer storage	cont. site																												
13 Insecticide storage																													
14 Abandoned water well																													
15 Oil well/Gas well																													
<table border="1" style="width:100%"><thead><tr><th>FROM</th><th>TO</th><th>PLUGGING MATERIALS</th></tr></thead><tbody><tr><td>11.12</td><td>1</td><td>Bentonite</td></tr><tr><td>1</td><td>0</td><td>Concrete</td></tr><tr><td> </td><td> </td><td> </td></tr><tr><td> </td><td> </td><td> </td></tr><tr><td> </td><td> </td><td> </td></tr><tr><td> </td><td> </td><td> </td></tr><tr><td> </td><td> </td><td> </td></tr></tbody></table>						FROM	TO	PLUGGING MATERIALS	11.12	1	Bentonite	1	0	Concrete															
FROM	TO	PLUGGING MATERIALS																											
11.12	1	Bentonite																											
1	0	Concrete																											
7	CONTRACTOR'S OF LANDOWNER'S CERTIFICATION: This water well was plugged under my jurisdiction and was completed on (mo/day/year) 05/20/08 and this record is true to the best of my knowledge and belief. Kansas Water Well Contractor's License No. 585 This Water Well Record was completed on (mo/day/year) 06/11/08 under the business name of Associated Environmental, Inc. by (signature) B. Johnson 																												
INSTRUCTIONS: Use typewriter or ball point pen. Please press firmly and print clearly. Please fill in blanks, underline or circle the correct answers. Send top three copies to Kansas Department of Health and Environment, Bureau of Water, Geology Section, 1000 SW Jackson St., Ste. 420, Topeka, Kansas 66612-1367. Telephone: 785/296-5522 Send one to Water Well Owner and retain one for your records.																													