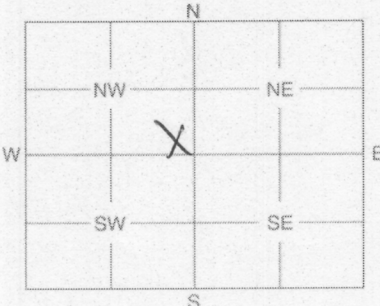


1	LOCATION OF WATER WELL: Wyandotte County:	Fraction SE ¼ SE ¼ NW ¼	Section Number 33	Township Number 11S	Range Number R25E																								
Distance and direction from nearest town or city street address of well if located within city? 2727 Roe Lane, Kansas City Kansas																													
2	WATER WELL OWNER: Unimark Oil RR #, St. Address, Box #: P.O. Box 1913 City, State, ZIP Code : El Dorado, AR 71731			Board of Agriculture, Division of Water Resources Application Number:																									
3	MARK WELL'S LOCATION WITH AN "X" IN SECTION BOX: <div style="text-align:center"></div>		4 DEPTH OF WELL 11.69 ft. WELL'S STATIC WATER LEVEL 1.81 ft. WELL WAS USED AS: <div style="display: flex; justify-content: space-between;"><div>1 Domestic 2 Irrigation 3 Feedlot 4 Industrial</div><div>5 Public Water Supply 6 Oil Field Water Supply 7 Domestic (Lawn & Garden) 8 Air Conditioning</div><div>9 Dewatering 10 Monitoring Well 11 Injection Well 12 Other</div></div> Was a chemical / bacteriological sample submitted to Department? Yes No X If yes, mo/day/yr sample was submitted Water Well Disinfected: Yes No X																										
5	TYPE OF BLANK CASING USED: <div style="display: flex; justify-content: space-between;"><div>1 Steel 2 PVC</div><div>3 RMP (SR) 4 ABS</div><div>5 Wrought 6 Asbestos-Cement</div><div>7 Fiberglass 8 Concrete Tile</div><div>9 Other (Specify below)</div></div> Blank casing diameter 2 in. Was casing pulled? Yes X No If yes, how much all Casing height above or below land surface in.																												
6	GROUT PLUG MATERIAL: 1 Neat cement 2 Cement grout Grout Plug Intervals: From 3 11.69 ft. to 1 ft. What is the nearest source of possible contamination: <div style="display: flex; justify-content: space-between;"><div>1 Septic tank 2 Sewer lines 3 Watertight sewer lines 4 Lateral lines 5 Cess pool</div><div>6 Seepage pit 7 Pit privy 8 Sewage lagoon 9 Feedyard 10 Livestock pens</div><div>11 Fuel storage 12 Fertilizer storage 13 Insecticide storage 14 Abandoned water well 15 Oil well/Gas well</div><div>16 Other (specify below) cont. site</div></div> Direction from well? How many feet?																												
<table border="1" style="width:100%"><thead><tr><th>FROM</th><th>TO</th><th>PLUGGING MATERIALS</th></tr></thead><tbody><tr><td>11.69</td><td>1</td><td>Bentonite</td></tr><tr><td>1</td><td>0</td><td>Concrete</td></tr><tr><td> </td><td> </td><td> </td></tr><tr><td> </td><td> </td><td> </td></tr><tr><td> </td><td> </td><td> </td></tr><tr><td> </td><td> </td><td> </td></tr><tr><td> </td><td> </td><td> </td></tr></tbody></table>						FROM	TO	PLUGGING MATERIALS	11.69	1	Bentonite	1	0	Concrete															
FROM	TO	PLUGGING MATERIALS																											
11.69	1	Bentonite																											
1	0	Concrete																											
7	CONTRACTOR'S OF LANDOWNER'S CERTIFICATION: This water well was plugged under my jurisdiction and was completed on (mo/day/year) 05/20/08 and this record is true to the best of my knowledge and belief. Kansas Water Well Contractor's License No. 585 06/11/08 under the business name of Associated Environmental, Inc. by (signature) B. Johnson																												
INSTRUCTIONS: Use typewriter or ball point pen. Please press firmly and print clearly. Please fill in blank, underline or circle the correct answers. Send top three copies to Kansas Department of Health and Environment, Bureau of Water, Geology Section, 1000 SW Jackson St., Ste. 420, Topeka, Kansas 66612-1367. Telephone: 785/296-5522. Send one to Water Well Owner and retain one for your records.																													