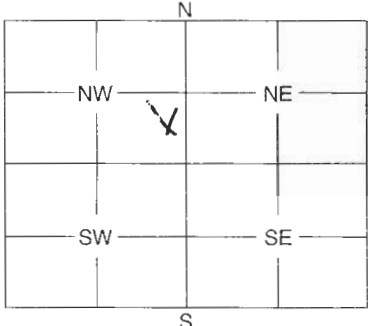


1	LOCATION OF WATER WELL: County: <u>Wyandotte</u>	Fraction <u>NESE NW</u> $\frac{1}{4}$ $\frac{1}{4}$ $\frac{1}{4}$	Section Number <u>22</u>	Township Number <u>11S</u>	Range Number <u>25</u> <u>EW</u>
---	---	---	-----------------------------	-------------------------------	-------------------------------------

Distance and direction from nearest town or city street address of well if located within city?

835 South St. Paul St., Kansas City, KS

2	WATER WELL OWNER: <u>Law Projects</u> RR #, St. Address, Box #: <u>PO Box 5306</u> City, State, ZIP Code: <u>Kansas City, KS 66119</u>	Board of Agriculture, Division of Water Resources Application Number:
---	--	--

3	MARK WELL'S LOCATION WITH AN "X" IN SECTION BOX: 	4	DEPTH OF WELL <u>20'</u> ft. WELL'S STATIC WATER LEVEL <u>Dry</u> ft. WELL WAS USED AS: 1 Domestic 2 Irrigation 3 Feedlot 4 Industrial 5 Public Water Supply 6 Oil Field Water Supply 7 Domestic (Lawn & Garden) 8 Air Conditioning 9 Dewatering 10 <u>Monitoring Well</u> 11 Injection Well 12 Other Was a chemical / bacteriological sample submitted to Department? Yes No <u>X</u> If yes, mo/day/yr sample was submitted Water Well Disinfected: Yes No <u>X</u>
---	--	---	--

5	TYPE OF BLANK CASING USED: 1 <u>Steel</u> 2 <u>PVC</u> 3 RMP (SR) 4 ABS 5 Wrought 6 Asbestos-Cement 7 Fiberglass 8 Concrete Tile 9 Other (Specify below) Blank casing diameter <u>2.0</u> in. Was casing pulled? Yes <u>X</u> No If yes, how much <u>20'</u> Casing height above or below land surface <u>N/A</u> in.
---	--

6	GROUT PLUG MATERIAL: 1 <u>Neat cement</u> 2 Cement grout 3 <u>Bentonite</u> 4 Other <u>Clay</u> Grout Plug Intervals: From <u>20'</u> ft. to <u>3'</u> ft., From <u>3'</u> ft. to <u>0'</u> ft., From to ft. What is the nearest source of possible contamination: 1 Septic tank 6 Seepage pit 11 <u>Fuel storage Farmer</u> 16 Other (specify below) 2 Sewer lines 7 Pit privy 12 Fertilizer storage 3 Watertight sewer lines 8 Sewage lagoon 13 Insecticide storage 4 Lateral lines 9 Feedyard 14 Abandoned water well 5 Cess pool 10 Livestock pens 15 Oil well/Gas well Direction from well? <u>East</u> How many feet? <u>10'</u>
---	--

FROM	TO	PLUGGING MATERIALS
<u>20'</u>	<u>3'</u>	<u>Bentonite</u>
<u>3'</u>	<u>0'</u>	<u>Compacted Clay</u>

7	CONTRACTOR'S OF LANDOWNER'S CERTIFICATION: This water well was plugged under my jurisdiction and was completed on (mo/day/year) <u>9/18/08</u> and this record is true to the best of my knowledge and belief. Kansas Water Well Contractor's License No. <u>732</u> This Water Well Record was completed on (mo/day/year) <u>9/22/08</u> by (signature) <u>James Burke</u> under the business name of <u>G-B Environmental</u>
---	--

INSTRUCTIONS: Use typewriter or ball point pen. Please press firmly and print clearly. Please fill in blanks, underline or circle the correct answers. Send top three copies to Kansas Department of Health and Environment, Bureau of Water, Geology Section, 1000 SW Jackson St., Ste. 420, Topeka, Kansas 66612-1367. Telephone: 785/296-5522. Send one to Water Well Owner and retain one for your records.