

mW-1R


WATER WELL PLUGGING RECORD Form WWC-5P KSA 82a-1212 ID NO. 374835

1 LOCATION OF WATER WELL: County: WYANDOTTE Fraction: NW 1/4 SE 1/4 NW 1/4 Section Number: 22 Township Number: T11S Range Number: R25E

Distance and direction from nearest town or city street address of well if located within city?
FROM CENTER OF INTERSECTION OF PAKHARD & OSAGE, GO 1000 FT EAST, 430 FEET NORTH

2 WATER WELL OWNER: RICHARD ARNOLD
RR#, St. Address, Box #: GRANITE SHIP BY TRUCK, CO.
City, State ZIP Code: P.O. Box 2936
KANSAS CITY, KS 66110
Global Positioning Systems (decimal degrees, min. of 4 digits)
Latitude: 39° 5' 8.17"
Longitude: 94° 37' 16.49"
Elevation: 746.22 TOP OF CASING
Datum: _____
Data Collection Method: GOOGLE EARTH/SURVEY

3 MARK WELL'S LOCATION WITH AN "X" IN SECTION BOX:

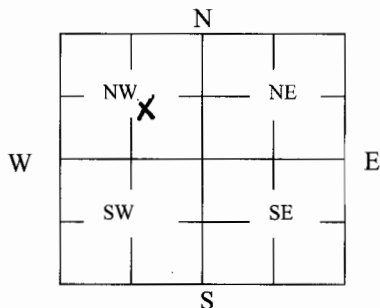

4 DEPTH OF WELL 35.0 ft.

WELL'S STATIC WATER LEVEL 23.0 ft

WELL WAS USED AS:

- | | | |
|--------------|----------------------------|----------------------|
| 1 Domestic | 5 Public Water Supply | 9 Dewatering |
| 2 Irrigation | 6 Oil Field Water Supply | <u>10</u> Monitoring |
| 3 Feedlot | 7 Domestic (Lawn & Garden) | 11 Injection Well |
| 4 Industrial | 8 Air Conditioning | 12 Other _____ |

Was a chemical/bacteriological sample submitted to Department? Yes No

5 TYPE OF BLANK CASING USED:

- | | | | | |
|--------------|------------|-------------------|-----------------|-------------------------|
| 1 Steel | 3 RMP (SR) | 5 Wrought | 7 Fiberglass | 9 Other (Specify below) |
| <u>2 PVC</u> | 4 ABS | 6 Asbestos-Cement | 8 Concrete Tile | |

Blank casing diameter 2 in. Was casing pulled? Yes X No _____ If yes, how much 35'
Casing height above or below land surface 4 in.

6 GROUT PLUG MATERIAL: 1 Neat cement 2 Cement grout 3 Bentonite 4 Other conc.

Grout Plug Intervals: From 35 ft. to 2 ft., From _____ ft. to _____ ft., From 2' to 0' ft.

What is the nearest source of possible contamination:

- | | | | |
|--------------------------|-------------------|-------------------------|----------------------------|
| 1 Septic tank | 6 Seepage pit | <u>11 Fuel Storage</u> | 16 Other (specify below) |
| 2 Sewer lines | 7 Pit privy | 12 Fertilizer storage | |
| 3 Watertight sewer lines | 8 Sewage lagoon | 13 Insecticide storage | |
| 4 Lateral lines | 9 Feedyard | 14 Abandoned water well | Direction from well? _____ |
| 5 Cess pool | 10 Livestock pens | 15 Oil well/Gas well | How many feet? _____ |

FROM	TO	PLUGGING MATERIALS	FROM	TO	PLUGGING MATERIALS
<u>35'</u>	<u>2</u>	<u>bentonite chips</u>			
<u>2'</u>	<u>0'</u>	<u>conc.</u>			

7 CONTRACTOR'S OR LANDOWNER'S CERTIFICATION: This water well was plugged under my jurisdiction and was completed on (mo/day/year) 1-30-09 and this record is true to the best of my knowledge and belief. Kansas Water Well Contractor's License No. 614. This Water Well Record was completed on (mo/day/year) 3/2/09 under the business name of TETRA TECH, INC. by (signature) Lawrence R. Kelly

INSTRUCTIONS: Use typewriter or ballpoint pen. Please press firmly and print clearly. Please fill in blanks, underline or circle the correct answers. Send top three copies to Kansas Department of Health and Environment, Bureau of Water, Geology Section, 1000 SW Jackson St., Ste. 420, Topeka, Kansas 66612-1367. Telephone: 785/296-5522. Send one to Water Well Owner and retain one for your records. Visit us at <http://www.kdheks.gov/geo/waterwells>.