

WATER WELL PLUGGING RECORD Form WWC-5P

KSA 82a-1212

ID NO.

374800

1 LOCATION OF WATER WELL:

County: WYANDOTTE

Fraction NW

SE 1/4 SE 1/4 NW 1/4

Section Number

22

Township Number

T11S

Range Number

R2S E/W

Distance and direction from nearest town or city street address of well if located within city?

FROM CENTER OF INTERSECTION OF PALMARD & OGAPE, 60 270' EAST, THEN 370 FEET NORTH

2 WATER WELL OWNER:

RR#, St. Address, Box #:

RICARDO ADWOLA
GRAHAM STIP BYTRUCKY LO

City, State ZIP Code:

P.O. Box 2936
KANSAS CITY, KS 66110

Global Positioning Systems (decimal degrees, min. of 4 digits)

Latitude: 39° 05' 7.66"


Longitude: 94° 37' 23.97"

Elevation: 746.48 TOP OF GAS INW

Datum:

Data Collection Method: GOOGLE EARTH SURVEY

3 MARK WELL'S LOCATION WITH AN "X" IN SECTION BOX:

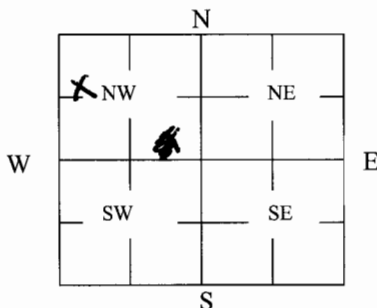

4 DEPTH OF WELL

35 ft.

WELL'S STATIC WATER LEVEL 26 ft.

WELL WAS USED AS:

- 1 Domestic
- 2 Irrigation
- 3 Feedlot
- 4 Industrial

- 5 Public Water Supply
- 6 Oil Field Water Supply
- 7 Domestic (Lawn & Garden)
- 8 Air Conditioning

- 9 Dewatering
- 10 Monitoring
- 11 Injection Well
- 12 Other

Was a chemical/bacteriological sample submitted to Department? Yes No

5 TYPE OF BLANK CASING USED:

- 1 Steel
- 2 PVC
- 3 RMP (SR)
- 4 ABS
- 5 Wrought
- 6 Asbestos-Cement
- 7 Fiberglass
- 8 Concrete Tile
- 9 Other (Specify below)

Blank casing diameter 2 in. Was casing pulled? Yes X No If yes, how much 35-
Casing height above or below land surface 5 in.

6 GROUT PLUG MATERIAL:

- 1 Neat cement
- 2 Cement grout
- 3 Bentonite
- 4 Other CONC

Grout Plug Intervals: From 26 ft. to 2 ft., From ft. to ft., From 2- to 0 ft.

What is the nearest source of possible contamination:

- 1 Septic tank
- 2 Sewer lines
- 3 Watertight sewer lines
- 4 Lateral lines
- 5 Cess pool
- 6 Seepage pit
- 7 Pit privy
- 8 Sewage lagoon
- 9 Feedyard
- 10 Livestock pens
- 11 Fuel Storage
- 12 Fertilizer storage
- 13 Insecticide storage
- 14 Abandoned water well
- 15 Oil well/Gas well
- 16 Other (specify below)

Direction from well?
How many feet?

FROM	TO	PLUGGING MATERIALS	FROM	TO	PLUGGING MATERIALS
<u>26-</u>	<u>2-</u>	<u>bentonite chips</u>			
<u>2-</u>	<u>0-</u>	<u>conc.</u>			

7 CONTRACTOR'S OR LANDOWNER'S CERTIFICATION:

This water well was plugged under my jurisdiction and was completed on (mo/day/year) 1-30-09 and this record is true to the best of my knowledge and belief. Kansas Water Well Contractor's License No. 614. This Water Well Record was completed on (mo/day/year) 3/2/09 under the business name of TEPA TECH, INC. by (signature) Lawrence R. Kelly

INSTRUCTIONS: Use typewriter or ballpoint pen. Please press firmly and print clearly. Please fill in blanks, underline or circle the correct answers. Send top three copies to Kansas Department of Health and Environment, Bureau of Water, Geology Section, 1000 SW Jackson St., Ste. 420, Topeka, Kansas 66612-1367. Telephone: 785/296-5522. Send one to Water Well Owner and retain one for your records. Visit us at <http://www.kdheks.gov/geo/waterwells>.