

mw 5R

WATER WELL PLUGGING RECORD Form WWC-5P

KSA 82a-1212

ID NO.


374062

1 LOCATION OF WATER WELL: County: <u>WYANDOTT</u>	Fraction <u>NW 1/4 SE 1/4 NW 1/4</u>	Section Number <u>22</u>	Township Number <u>T 11 S</u>	Range Number <u>R 26 E</u>
--	---	-----------------------------	----------------------------------	-------------------------------

Distance and direction from nearest town or city street address of well if located within city?
FROM INTERSECTION OF PALMARD & OSAGE, 60 1000' EAST, THEN 215 FEET NORTH

2 WATER WELL OWNER: <u>RICHARD ARNOLD</u> <u>GRANITE SHIP BY TRUCK CO</u> RR#, St. Address, Box #: <u>P.O. Box 2936</u> City, State ZIP Code: <u>KANSAS CITY, KS 66110</u>	Global Positioning Systems (decimal degrees, min. of 4 digits) Latitude: <u>39° 05' 6.364</u> Longitude: <u>94° 37' 13.951</u> Elevation: <u>746.49 TOP OF CASING</u> Datum: Data Collection Method: <u>GOOGLE EARTH / JUNE 11</u>
---	---

3 MARK WELL'S LOCATION WITH AN "X" IN SECTION BOX:

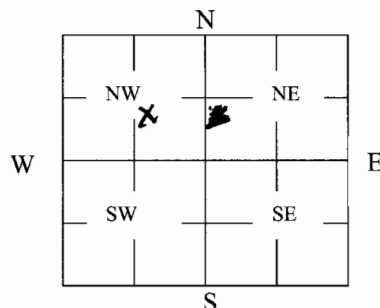

4 DEPTH OF WELL 35 ft.

WELL'S STATIC WATER LEVEL 26 ft.

WELL WAS USED AS:

- | | | |
|--------------|----------------------------|----------------------|
| 1 Domestic | 5 Public Water Supply | 9 Dewatering |
| 2 Irrigation | 6 Oil Field Water Supply | <u>10 Monitoring</u> |
| 3 Feedlot | 7 Domestic (Lawn & Garden) | 11 Injection Well |
| 4 Industrial | 8 Air Conditioning | 12 Other _____ |

Was a chemical/bacteriological sample submitted to Department? Yes _____ No _____

5 TYPE OF BLANK CASING USED:

- | | | | | |
|--------------|------------|-------------------|-----------------|-------------------------|
| 1 Steel | 3 RMP (SR) | 5 Wrought | 7 Fiberglass | 9 Other (Specify below) |
| <u>2 PVC</u> | 4 ABS | 6 Asbestos-Cement | 8 Concrete Tile | |

Blank casing diameter 2 in. Was casing pulled? Yes X No _____ If yes, how much 35-
Casing height above or below land surface 4 in.

6 GROUT PLUG MATERIAL: 1 Neat cement 2 Cement grout 3 Bentonite 4 Other conc

Grout Plug Intervals: From 25 ft. to 2 ft., From _____ ft. to _____ ft., From 2- to 0 ft.

What is the nearest source of possible contamination:

- | | | | |
|--------------------------|-------------------|-------------------------|----------------------------|
| 1 Septic tank | 6 Seepage pit | <u>11 Fuel Storage</u> | 16 Other (specify below) |
| 2 Sewer lines | 7 Pit privy | 12 Fertilizer storage | |
| 3 Watertight sewer lines | 8 Sewage lagoon | 13 Insecticide storage | |
| 4 Lateral lines | 9 Feedyard | 14 Abandoned water well | Direction from well? _____ |
| 5 Cess pool | 10 Livestock pens | 15 Oil well/Gas well | How many feet? _____ |

FROM	TO	PLUGGING MATERIALS	FROM	TO	PLUGGING MATERIALS
<u>25-</u>	<u>2</u>	<u>bentonite chips</u>			
<u>2-</u>	<u>0-</u>	<u>conc.</u>			

7 CONTRACTOR'S OR LANDOWNER'S CERTIFICATION: This water well was plugged under my jurisdiction and was completed on (mo/day/year) 1-30-09 and this record is true to the best of my knowledge and belief. Kansas Water Well Contractor's License No. 614. This Water Well Record was completed on (mo/day/year) 3/2/09 under the business name of TETRA TECH, INC. by (signature) James R. Kelly

INSTRUCTIONS: Use typewriter or ballpoint pen. Please press firmly and print clearly. Please fill in blanks, underline or circle the correct answers. Send top three copies to Kansas Department of Health and Environment, Bureau of Water, Geology Section, 1000 SW Jackson St., Ste. 420, Topeka, Kansas 66612-1367. Telephone: 785/296-5522. Send one to Water Well Owner and retain one for your records. Visit us at <http://www.kdheks.gov/geo/waterwells>.