

mw 6 R

WATER WELL PLUGGING RECORD Form WWC-5P

KSA 82a-1212

ID NO.

374 B 40

1 LOCATION OF WATER WELL:

County: WYANDOTTE

Fraction

NW 1/4 SE 1/4 NW 1/4

Section Number

22

Township Number

T 11 S

Range Number

R 25 E

Distance and direction from nearest town or city street address of well if located within city?

FROM INTERSECTION OF PAUKATO & OSAGE, 60 900 FEET EAST, THEN 545 FEET NORTH

2 WATER WELL OWNER:

RICHARD ARNOLD

RR#, St. Address, Box #:

GRANITE SHIP BY TRUCK, W.P.O. Box 2936

City, State ZIP Code:

KANSAS CITY, KS 66110

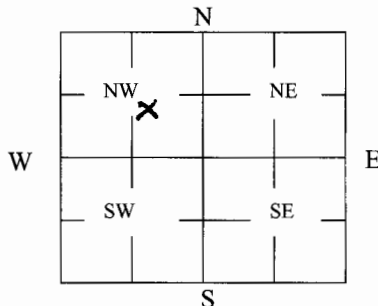
Global Positioning Systems (decimal degrees, min. of 4 digits)

Latitude: 39° 51' 9.104"Longitude: 94° 27' 17.911"Elevation: 743.95 TOP OF CASING

Datum:

Data Collection Method: GOOGLE EARTH / SURVEY

3 MARK WELL'S LOCATION WITH AN "X" IN SECTION BOX:

4 DEPTH OF WELL 35 ft.WELL'S STATIC WATER LEVEL 26 ft

WELL WAS USED AS:

- 1 Domestic
2 Irrigation
3 Feedlot
4 Industrial

- 5 Public Water Supply
6 Oil Field Water Supply
7 Domestic (Lawn & Garden)
8 Air Conditioning

- 9 Dewatering
10 Monitoring
11 Injection Well
12 Other _____

Was a chemical/bacteriological sample submitted to Department? Yes _____ No _____

5 TYPE OF BLANK CASING USED:

1 Steel

3 RMP (SR)

5 Wrought

7 Fiberglass

9 Other (Specify below)

2 PVC

4 ABS

6 Asbestos-Cement

8 Concrete Tile

Blank casing diameter 2 in.Was casing pulled? Yes X No _____If yes, how much 35-Casing height above or below land surface 5 in.

6 GROUT PLUG MATERIAL:

1 Neat cement

2 Cement grout

3 Bentonite

4 Other conc.Grout Plug Intervals: From 26 ft. to 2 ft., From _____ ft. to _____ ft., From 2 to 0 ft.

What is the nearest source of possible contamination:

1 Septic tank

6 Seepage pit

11 Fuel Storage

16 Other (specify below)

2 Sewer lines

7 Pit privy

12 Fertilizer storage

3 Watertight sewer lines

8 Sewage lagoon

13 Insecticide storage

4 Lateral lines

9 Feedyard

14 Abandoned water well

Direction from well? _____

5 Cess pool

10 Livestock pens

15 Oil well/Gas well

How many feet? _____

FROM	TO	PLUGGING MATERIALS	FROM	TO	PLUGGING MATERIALS
<u>26-</u>	<u>2-</u>	<u>bentonite chips</u>			
<u>2-</u>	<u>0-</u>	<u>conc.</u>			

7 CONTRACTOR'S OR LANDOWNER'S CERTIFICATION:

This water well was plugged under my jurisdiction and was completed on (mo/day/year) 1-30-09 and this record is true to the best of my knowledge and belief. Kansas WaterWell Contractor's License No. 614. This Water Well Record was completed on (mo/day/year) 3/2/09 under thebusiness name of TEPA TEST INC

by (signature)

James R. Kelly

INSTRUCTIONS: Use typewriter or ballpoint pen. Please press firmly and print clearly. Please fill in blanks, underline or circle the correct answers. Send top three copies to Kansas Department of Health and Environment, Bureau of Water, Geology Section, 1000 SW Jackson St., Ste. 420, Topeka, Kansas 66612-1367. Telephone: 785/296-5522. Send one to Water Well Owner and retain one for your records. Visit us at <http://www.kdheks.gov/geo/waterwells>.