

m w - 7

WATER WELL PLUGGING RECORD Form WWC-5P

KSA 82a-1212

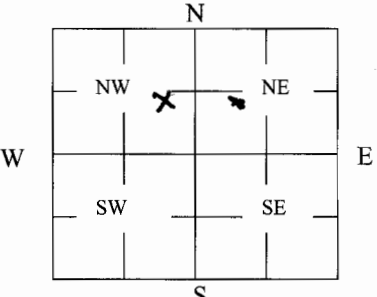
ID NO.

374824

1 LOCATION OF WATER WELL: County: <u>WYANDOTTE</u>	Fraction <u>NW 1/4 SE 1/4 NW 1/4</u>	Section Number <u>22</u>	Township Number <u>T 15 S</u>	Range Number <u>R 25 E</u>
---	---	-----------------------------	----------------------------------	-------------------------------

Distance and direction from nearest town or city street address of well if located within city?
FROM THE CENTER OF INTERSECTION OF PALKAP & S RGE, 60 1195 FEET EAST, THEN 340 FEET NORTH

2 WATER WELL OWNER: <u>RICHARD ADKINS</u> RR#, St. Address, Box #: <u>GRANITE SHIP BY TRUCK CO</u> <u>P.O. Box 2936</u> City, State ZIP Code: <u>KANSAS CITY, KS 66110</u>	Global Positioning Systems (decimal degrees, min. of 4 digits) Latitude: <u>39° 51' 7.33"</u> Longitude: <u>94° 37' 13.82"</u> Elevation: <u>746.23 TOP OF CASINO</u> Datum: _____ Data Collection Method: <u>GOOGLE EARTH / SURVEY</u>
---	--

3 MARK WELL'S LOCATION WITH AN "X" IN SECTION BOX: 	4 DEPTH OF WELL <u>37</u> ft. WELL'S STATIC WATER LEVEL <u>28</u> ft. WELL WAS USED AS: <table border="0"> <tr> <td>1 Domestic</td> <td>5 Public Water Supply</td> <td>9 Dewatering</td> </tr> <tr> <td>2 Irrigation</td> <td>6 Oil Field Water Supply</td> <td><u>10 Monitoring</u></td> </tr> <tr> <td>3 Feedlot</td> <td>7 Domestic (Lawn & Garden)</td> <td>11 Injection Well</td> </tr> <tr> <td>4 Industrial</td> <td>8 Air Conditioning</td> <td>12 Other _____</td> </tr> </table> Was a chemical/bacteriological sample submitted to Department? Yes _____ No _____	1 Domestic	5 Public Water Supply	9 Dewatering	2 Irrigation	6 Oil Field Water Supply	<u>10 Monitoring</u>	3 Feedlot	7 Domestic (Lawn & Garden)	11 Injection Well	4 Industrial	8 Air Conditioning	12 Other _____

5 TYPE OF BLANK CASING USED: 1 Steel <u>2 PVC</u> 3 RMP (SR) 4 ABS 5 Wrought 6 Asbestos-Cement 7 Fiberglass 8 Concrete Tile 9 Other (Specify below) _____	Blank casing diameter <u>2</u> in. Was casing pulled? Yes <u>X</u> No _____ If yes, how much <u>37-</u> Casing height above or below land surface <u>5</u> in.
--	---

6 GROUT PLUG MATERIAL: 1 Neat cement 2 Cement grout <u>3 Bentonite</u> 4 Other <u>conc.</u>	Grout Plug Intervals: From <u>25.5</u> to <u>2</u> ft., From _____ ft. to _____ ft., From <u>2-</u> to <u>0</u> ft.
What is the nearest source of possible contamination: 1 Septic tank 2 Sewer lines 3 Watertight sewer lines 4 Lateral lines 5 Cess pool 6 Seepage pit 7 Pit privy 8 Sewage lagoon 9 Feedyard 10 Livestock pens <u>11 Fuel Storage</u> 12 Fertilizer storage 13 Insecticide storage 14 Abandoned water well 15 Oil well/Gas well 16 Other (specify below) _____	Direction from well? _____ How many feet? _____

FROM	TO	PLUGGING MATERIALS	FROM	TO	PLUGGING MATERIALS
<u>25.5</u>	<u>2-</u>	<u>bentonite chips</u>			
<u>2-</u>	<u>0-</u>	<u>conc.</u>			

7 CONTRACTOR'S OR LANDOWNER'S CERTIFICATION: This water well was plugged under my jurisdiction and was completed on (mo/day/year) <u>1-30-09</u> and this record is true to the best of my knowledge and belief. Kansas Water Well Contractor's License No. <u>614</u> . This Water Well Record was completed on (mo/day/year) <u>3/2/09</u> under the business name of <u>TETRA TECH, INC.</u> by (signature) <u>Laurence Kelly</u>
--

INSTRUCTIONS: Use typewriter or ballpoint pen. Please press firmly and print clearly. Please fill in blanks, underline or circle the correct answers. Send top three copies to Kansas Department of Health and Environment, Bureau of Water, Geology Section, 1000 SW Jackson St., Ste. 420, Topeka, Kansas 66612-1367. Telephone: 785/296-5522. Send one to Water Well Owner and retain one for your records. Visit us at <http://www.kdheks.gov/geo/waterwells>.