


1 LOCATION OF WATER WELL: County: **WYANDOTTE** Fraction: **SW 1/4 SW 1/4 SW 1/4** Section Number: **6** Township Number: **11 S** Range Number: **25 E/W**

Distance and direction from nearest town or city street address of well if located within city?

4626 STATE AVE., KANSAS CITY, KS 66102

2 WATER WELL OWNER: **ATLANTIC RICHFIELD COMPANY**
 RR#, St. Address, Box #: **2240 BLUESTONE DR.**
 City, State ZIP Code: **ST. CHARLES, MO 63303**
 Global Positioning Systems (decimal degrees, min. of 4 digits)
 Latitude: **~39.1170°**
 Longitude: **~-94.6859**
 Elevation: _____
 Datum: **WGS 84**
 Data Collection Method: **GOOGLE EARTH**

3 MARK WELL'S LOCATION WITH AN "X" IN SECTION BOX:

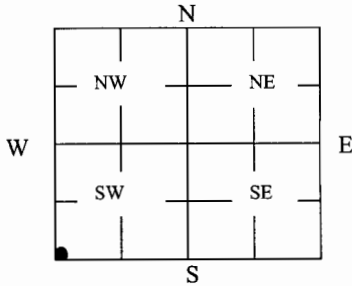

4 DEPTH OF WELL: **26.5** ft., **23', 19', 26'**
GEO PROBES

WELL'S STATIC WATER LEVEL _____ ft.

WELL WAS USED AS:

- 1 Domestic
- 5 Public Water Supply
- 9 Dewatering
- 2 Irrigation
- 6 Oil Field Water Supply
- 10 Monitoring
- 3 Feedlot
- 7 Domestic (Lawn & Garden)
- 11 Injection Well
- 4 Industrial
- 8 Air Conditioning
- 12 Other **PROBE SAMPLING / SOIL BORING**

Was a chemical/bacteriological sample submitted to Department? Yes _____ No

JOB# 090007-AR/D/KT-2
FORMER AMCO #2156

5 TYPE OF BLANK CASING USED:

- 1 Steel
- 3 RMP (SR)
- 5 Wrought
- 7 Fiberglass
- 2 PVC
- 4 ABS
- 6 Asbestos-Cement
- 8 Concrete Tile

Other (Specify below)
MACRO SAMPLERS/SHELBY TUBES

Blank casing diameter **2** in. Was casing pulled? Yes No _____ If yes, how much **ALL**
 Casing height above or below land surface _____ in.

6 GROUT PLUG MATERIAL: 1 Neat cement 2 Cement grout 3 Bentonite 4 Other _____

Grout Plug Intervals: From **0** ft. to **BOTTOM** ft., From _____ ft. to _____ ft., From _____ to _____ ft.

What is the nearest source of possible contamination:

- 1 Septic tank
- 6 Seepage pit
- 1 Fuel Storage
- 16 Other (specify below)
- 2 Sewer lines
- 7 Pit privy
- 12 Fertilizer storage
- 3 Watertight sewer lines
- 8 Sewage lagoon
- 13 Insecticide storage
- 4 Lateral lines
- 9 Feedyard
- 14 Abandoned water well
- 5 Cess pool
- 10 Livestock pens
- 15 Oil well/Gas well

Direction from well? **(ON SITE)**
 How many feet? **(ON SITE)**

FROM	TO	PLUGGING MATERIALS	FROM	TO	PLUGGING MATERIALS
0	26.5'	GRANULAR BENT. (SB-1)			
0	19'	GRANULAR BENT. (ST-1)			
0	23'	GRANULAR BENT. (SB-2)			
0	26'	GRANULAR BENT. (ST-2)			

7 CONTRACTOR'S OR LANDOWNER'S CERTIFICATION: This water well was plugged under my jurisdiction and was completed on (mo/day/year) **6/17/09** and this record is true to the best of my knowledge and belief. Kansas Water Well Contractor's License No. **788**. This Water Well Record was completed on (mo/day/year) **7-14-09** under the business name of **ROBERTS ENV. DRILLING, INC.** by (signature) **Charley Roberts**

INSTRUCTIONS: Use typewriter or ballpoint pen. Please press firmly and print clearly. Please fill in blanks, underline or circle the correct answers. Send top three copies to Kansas Department of Health and Environment, Bureau of Water, Geology Section, 1000 SW Jackson St., Ste. 420, Topeka, Kansas 66612-1367. Telephone: 785/296-5522. Send one to Water Well Owner and retain one for your records. Visit us at <http://www.kdheks.gov/geo/waterwells>.

(WHITE COPY)