

WATER WELL PLUGGING RECORD Form WWC-5P

KSA 82a-1212

ID NO.

mw-4
00367185

1 LOCATION OF WATER WELL: County: Wyandotte Fraction SE 1/4 Section Number 9 Township Number 11 Range Number 25 EW

Distance and direction from nearest town or city street address of well if located within city?

401 N. 14th St, Kansas City, KS

2 WATER WELL OWNER:

RR#, St. Address, Box #:

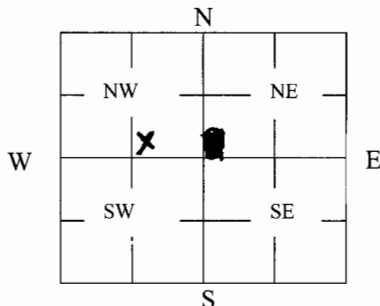
City, State ZIP Code:

Glee Montgomery
401 N. 14th St
Kansas City, KS

Global Positioning Systems (decimal degrees, min. of 4 digits)

Latitude: N 39.10964Longitude: W 094.64441Elevation: 917.55'Datum: 117.84'Data Collection Method: Legal Survey GPS

3 MARK WELL'S LOCATION WITH AN "X" IN SECTION BOX:

4 DEPTH OF WELL 17.01 ft.WELL'S STATIC WATER LEVEL 8.93 ft

WELL WAS USED AS:

- 1 Domestic
- 2 Irrigation
- 3 Feedlot
- 4 Industrial

- 5 Public Water Supply
- 6 Oil Field Water Supply
- 7 Domestic (Lawn & Garden)
- 8 Air Conditioning

- 9 Dewatering
- 10 Monitoring
- 11 Injection Well
- 12 Other

Was a chemical/bacteriological sample submitted to Department? Yes _____ No _____

5 TYPE OF CASING USED:

1 Steel

3 RMP (SR)

5 Wrought

7 Fiberglass

9 Other (Specify below)

2 PVC

4 ABS

6 Asbestos-Cement

8 Concrete Tile

Blank casing diameter 2 in. Was casing pulled? Yes X No _____ If yes, how much 3 feet

Casing height above or below land surface _____ in.

6 GROUT PLUG MATERIAL:

1 Neat cement

2 Cement grout

3 Bentonite

4 Other _____

Grout Plug Intervals: From 8" ft. to 17.01 ft., From _____ ft. to _____ ft., From _____ to _____ ft.

What is the nearest source of possible contamination:

1 Septic tank

6 Seepage pit

11 Fuel Storage

16 Other (specify below)

2 Sewer lines

7 Pit privy

12 Fertilizer storage

3 Watertight sewer lines

8 Sewage lagoon

13 Insecticide storage

4 Lateral lines

9 Feedyard

14 Abandoned water well

Direction from well? _____

5 Cess pool

10 Livestock pens

15 Oil well/Gas well

How many feet? _____

FROM	TO	PLUGGING MATERIALS	FROM	TO	PLUGGING MATERIALS
0"	8"	Concrete			
8"	17.01'	Bentonite			

7 CONTRACTOR'S OR LANDOWNER'S CERTIFICATION: This water well was plugged under my jurisdiction and was completed on (mo/day/year) 08/06/09 and this record is true to the best of my knowledge and belief. Kansas Water Well Contractor's License No. _____. This Water Well Record was completed on (mo/day/year) 08/17/09 under the business name of Environmental Remediation by (signature) _____

INSTRUCTIONS: Use typewriter or ballpoint pen. Please press firmly and print clearly. Please fill in blanks, underline or circle the correct answers. Send top three copies to Kansas Department of Health and Environment, Bureau of Water, Geology Section, 1000 SW Jackson St., Ste. 420, Topeka, Kansas 66612-1367. Telephone: 785/296-5522. Send one to Water Well Owner and retain one for your records. Visit us at <http://www.kdheks.gov/geo/waterwells>.