

**Form WWC-5**


Division of Water Resources App. No.

KSA 82a-1212

Check: ☒ White Copy, ☐ Blue Copy, ☐ Pink Copy

**LEGEND:**

- MW-04 MONITORING WELL
- 837.64 Well Identification
- Ground Water Elevation
- SWW-03 Well not sampled per RFP.

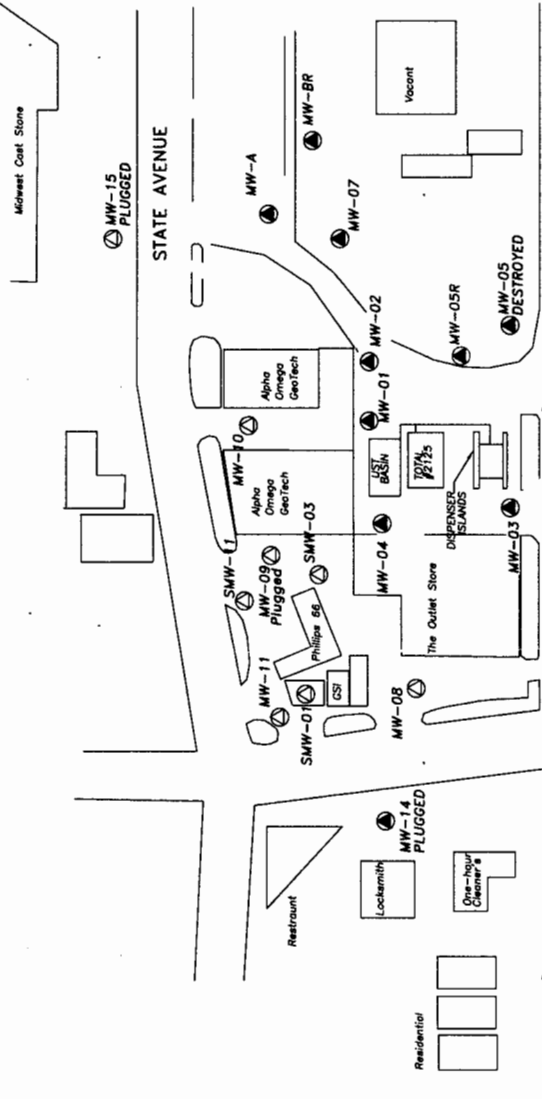

MINNESOTA AVENUE

18th STREET

17th STREET

**SITE MAP**

TOTAL RETAIL #2125  
1710 MINNESOTA AVENUE  
KANSAS CITY, KANSAS

FIGURE 1 PROJECT NUMBER: 17.75250.2125

CHECKED BY: JLA 07/06/09  
DRAWN BY: JLA 06/07/07

