

WATER WELL PLUGGING RECORD Form WWC-5P

KSA 82a-1212

ID NO.

MW-3

1 LOCATION OF WATER WELL: WANDOTTE Shawnee County	Fraction NE ¼ NE ¼ NE ¼	Section Number 22	Township Number 11 S	Range Number R 25 E
--	----------------------------	----------------------	-------------------------	------------------------

Distance and direction from nearest town or city street address of well if located within city?

Well was located at 624 (686) Adams St., Kansas City, KS

2 WATER WELL OWNER:

Shawnee Transportation

RR#, St. Address, Box #:

624 (686) Adams St.

City, State ZIP Code:

Kansas City, KS 66105

Global Positioning Systems (decimal degrees, min. of 4 digits)

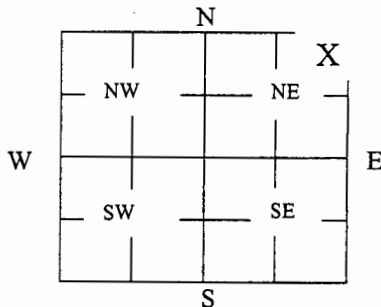
Latitude:

Longitude:

Elevation:

Datum:

Data Collection Method:

3 MARK WELL'S LOCATION WITH AN "X" IN SECTION BOX:

4 DEPTH OF WELL 26.75 **ft.**

 WELL'S STATIC WATER LEVEL 17.44 **ft**

WELL WAS USED AS:

☒ X

1 Domestic

5 Public Water Supply

9 Dewatering

2 Irrigation

6 Oil Field Water Supply

☒ 10 Monitoring

3 Feedlot

7 Domestic (Lawn & Garden)

11 Injection Well

4 Industrial

8 Air Conditioning

12 Other

 Was a chemical/bacteriological sample submitted to Department? Yes ☐ No ☒
5 TYPE OF BLANK CASING USED:
☐ 1 Steel

☐ 3 RMP (SR)

☐ 5 Wrought

☐ 7 Fiberglass

☐ 9 Other (Specify below)

☒ 2 PVC

☐ 4 ABS

☐ 6 Asbestos-Cement

☐ 8 Concrete Tile

 Blank casing diameter 2 in. Was casing pulled? Yes ☒ No ☐ If yes, how much 3'

Casing height above or below land surface _____ in.

6 GROUT PLUG MATERIAL:
☐ 1 Neat cement

☐ 2 Cement grout

☐ 3 Bentonite

☐ 4 Other

 Grout Plug Intervals: From 2 0 ft. to 0.5 ft., From 3 0.5 ft. to 26.78 ft., From _____ to _____ ft.

What is the nearest source of possible contamination:

☐ 1 Septic tank

☐ 6 Seepage pit

☐ 11 Fuel Storage

☐ 16 Other (specify below)

☐ 2 Sewer lines

☐ 7 Pit privy

☐ 12 Fertilizer storage

☐ Contaminated Site

☐ 3 Watertight sewer lines

☐ 8 Sewage lagoon

☐ 13 Insecticide storage

☐ 4 Lateral lines

☐ 9 Feedyard

☐ 14 Abandoned water well

Direction from well?

☐ 5 Cess pool

☐ 10 Livestock pens

☐ 15 Oil well/Gas well

How many feet?

FROM	TO	PLUGGING MATERIALS	FROM	TO	PLUGGING MATERIALS
0'	0.5'	Concrete			
0.5'	26.78'	Bentonite Chips			

7 CONTRACTOR'S OR LANDOWNER'S CERTIFICATION: This water well was plugged under my jurisdiction and was completed on (mo/day/year) 05/12/11 and this record is true to the best of my knowledge and belief. Kansas Water Well Contractor's License No. 585. This Water Well Record was completed on (mo/day/year) 05/10/11 under the business name of Associated Environmental, Inc. by (signature) [Signature]

INSTRUCTIONS: Use typewriter or ballpoint pen. Please press firmly and print clearly. Please fill in blanks, underline or circle the correct answers. Send top three copies to Kansas Department of Health and Environment, Bureau of Water, Geology Section, 1000 SW Jackson St., Ste. 420, Topeka, Kansas 66612-1367. Telephone: 785/296-5522. Send one to Water Well Owner and retain one for your records. Visit us at <http://www.kdheks.gov/waterwell/index.html>.