


2555 S. Ferree – Kansas City

Application Number:

800.52 (TOC)

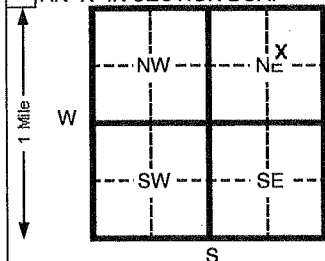

Was a chemical/bacteriological sample submitted to Department? Yes No **X** If yes, mo/day/yr sample was

Was a chemical/bacteriological sample submitted to Department? Yes _____ No **X** If yes, mo/day/yr sample was submitted _____

Water Well Disinfected? Yes _____ No **X**

Threaded Flush

10 Asbestos-cement

	From	ft. to	ft.	From	ft. to	ft.
1						
2						
Direction from well? _____ How many feet? _____

5	19	Clay, with silt, dark brown			
---	----	-----------------------------	--	--	--

Longitude: -94.632500

under the business name of **Geotechnical Services Inc.** by (signature) *Mark Lawrence*

INSTRUCTIONS: Please fill in blanks and circle the correct answers. Send three copies to Kansas Department of Health and Environment, Bureau of Water, 1000 S W Jackson St., Ste. 420, Topeka, Kansas 66612-1367. Telephone: 913-296-5545. Send one to WATER WELL OWNER and retain one for your records.