

## WATER WELL PLUGGING RECORD Form WWC-5P

KSA 82a-1212

ID NO.

4P

## 1 LOCATION OF WATER WELL:

County: Wyandotte

Fraction

SE 1/4 NW 1/4 SE 1/4 NW 1/4

Section Number

2

Township Number

T 11 S

Range Number

25

☒ E ☐ W

Street/Rural Address of Well Location; if unknown, distance & direction from nearest town or intersection: If at owner's address, check here ☒

## Global Positioning Systems (GPS) information:

Latitude: 39.12483 (in decimal degrees)

Longitude: -90.6061 (in decimal degrees)

Elevation: 749.58

Datum: ☐ WGS84, ☒ NAD83, ☐ NAD27

## Collection Method:


☒ GPS unit (Make/Model: Trimble GeoXT 2008 Series☐ Digital Map/Photo, ☐ Topographic Map, ☐ Land SurveyEst. Accuracy: ☒ < 3 m, ☐ 3-5 m, ☐ 5-15 m, ☐ > 15 m

## 2 WATER WELL OWNER: Fairfax Drainage District

RR#, St. Address, Box #: 1620 Fairfax Trafficway

City, State ZIP Code: Kansas City, KS 66115

## 3 MARK WELL'S LOCATION WITH AN "X" IN SECTION BOX:

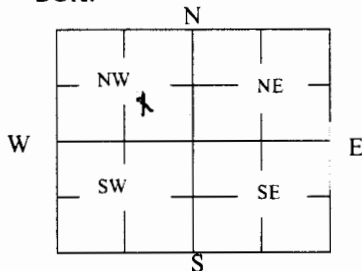

## 4 DEPTH OF WELL 93.02 ft.

WELL'S STATIC WATER LEVEL 25.9 ft

WELL WAS USED AS:

☐ Domestic  
☐ Irrigation  
☐ Feedlot  
☐ Industrial

☐ Public Water Supply  
☐ Oil Field Water Supply  
☐ Domestic (Lawn & Garden)  
☐ Air Conditioning

☐ Dewatering  
☐ Monitoring  
☐ Injection Well  
☒ Other Relief Well
Was a chemical/bacteriological sample submitted to Department? Yes ☐ No ☒

## 5 TYPE OF BLANK CASING USED:

☒ Steel  
☐ PVC☐ RMP (SR)  
☐ ABS☐ Wrought  
☐ Asbestos-Cement☐ Fiberglass  
☐ Concrete Tile☐ Other (Specify below)

Blank casing diameter \_\_\_\_\_ in. Was casing pulled? Yes ☐ No ☒ If yes, how much \_\_\_\_\_

Casing height above or below land surface (13.84) in. ft.

## 6 GROUT PLUG MATERIAL:

☐ Neat cement☒ Cement grout☐ Bentonite☐ Other

Grout Plug Intervals: From 13.84 ft. to 33.84 ft., From \_\_\_\_\_ ft. to \_\_\_\_\_ ft., From \_\_\_\_\_ to \_\_\_\_\_ ft.

What is the nearest source of possible contamination:

☐ Septic tank  
☐ Sewer lines  
☐ Watertight sewer lines  
☐ Lateral lines  
☐ Cess pool

☐ Seepage pit  
☐ Pit privy  
☐ Sewage lagoon  
☐ Feedyard  
☐ Livestock pens

☐ Fuel Storage  
☐ Fertilizer storage  
☐ Insecticide storage  
☐ Abandoned water well  
☐ Oil well/Gas well
☒ Other (specify below)  
Underground Hydrocarbons from Old Refinery

Direction from well? Northwest

How many feet? 100

FROM	TO	PLUGGING MATERIALS	FROM	TO	PLUGGING MATERIALS
13.84	33.84	Cement Grout			
33.84	93.02	Chlorinated Silica Sand			

7 CONTRACTOR'S OR LANDOWNER'S CERTIFICATION: This water well was plugged under my jurisdiction and was completed on (mo/day/year) 11/04/2010 and this record is true to the best of my knowledge and belief. Kansas Water Well Contractor's License No. \_\_\_\_\_. This Water Well Record was completed on (mo/day/year) 04/16/2012 under the business name of Fairfax Drainage District by (signature) Steve P. DeG... P.E.

INSTRUCTIONS: Use typewriter or ballpoint pen. Please press firmly and print clearly. Please fill in blanks, underline or circle the correct answers. Send top three copies to Kansas Department of Health and Environment, Bureau of Water, Geology Section, 1000 SW Jackson St., Ste. 420, Topeka, Kansas 66612-1367. Telephone: 785/296-5524. Send one to Water Well Owner and retain one for your records. Visit us at <http://www.kdheks.gov/waterwell/index.html>.

Check one: ☐ White Copy ☐ Blue Copy ☐ Pink Copy