

Division of Water Resources App. No.

INSTRUCTIONS: Use typewriter or ball point pen. PLEASE PRESS FIRMLY and PRINT clearly. Please fill in blanks and check the correct answers. Send three copies (white, blue, pink) to Kansas Department of Health and Environment, Bureau of Water, Geology Section, 1000 SW Jackson St., Suite 420, Topeka, Kansas 66612-1367. Telephone 785-296-5522. Send one copy to WATER WELL OWNER and retain one for your records. Include fee of \$5.00 for each constructed well. Visit us at <http://www.kdheks.gov/waterwell/index.html>.

SITE SKETCH:

MONITORING WELL LOG

PROJECT NAME: GALAMBA

PROJECT NO.: 01-R584

PROBE NO.: MW1

DATE: 9-8-03

SHEET: 1 of 1

LOGGED BY: GFM

DRILLED BY: JB

SURFACE ELEVATION:

TOTAL DEPTH: 40'

FIELD SCREEN METHOD: PID


DRILLING METHOD: HSA

SAMPLING METHOD: SPLIT SPOON

GRAVEL PACK:

GROUT: BENTONITE

DEPTH, ft.	SAMPLE		DESCRIPTION	UNIFIED SOIL CLASSIFICATION	WELL CONSTRUCTION
	RECOVERY	FIELD SCREEN RESULTS (ppm)			
0					
50	24		DRY BROWN SOIL THEN BLACK CINDERS		
5					
50	104		DISCOLORED TAN FINE SAND, TAN MOIST		
10					
50	44		DISCOLORED FINE TAN SAND, DRY		
15					
60	11		FINE SILTY SAND DISCOLORED TAN		
20					
60	8		FINE SILTY SAND DISCOLORED TAN SATURATED SAND LENSES		
25					
60	7		DRY DISCOLORED TAN SAND		
30					
80	4		FINE TAN SAND BECOMES SATURATED AT 32'		
35					
80	0		SATURATED TAN SAND		
40					
			40' B.O.B.		
45					
50					

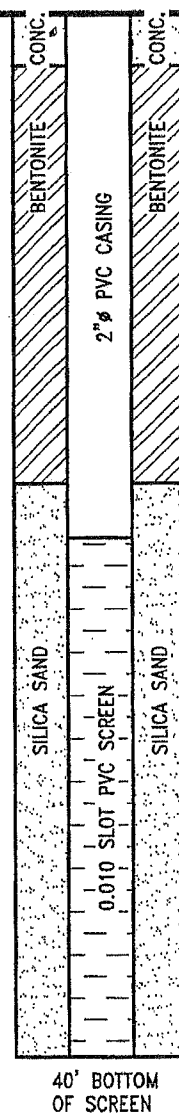

Kingston Environmental Services Inc.