

MW-9D

WATER WELL RECORD


Form WWC-5

Division of Water Resources App. No.

1 LOCATION OF WATER WELL: County: Wyandotte, Fraction NE 1/4 NE 1/4 1/4 1/4, Section Number 15, Township No. T 11 S, Range Number R 25 NE W

Street/Rural Address of Well Location; if unknown, distance & direction from nearest town or intersection: If at owner's address, check here [X]. Global Positioning System (GPS) information: Latitude: 29.735.6, Longitude: 207.2317, Elevation: 747.46

2 WATER WELL OWNER: PBI/Gordon Facility, RR#, Street Address, Box #: 300 S. 3RD ST., City, State, ZIP Code: KANSAS CITY KS. 66205

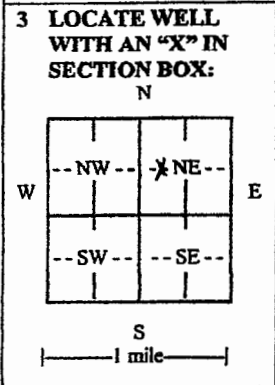

3 LOCATE WELL WITH AN 'X' IN SECTION BOX: 4 DEPTH OF COMPLETED WELL: 70 ft. Depth(s) Groundwater Encountered (1) 20 ft (2) ft (3) ft. WELL'S STATIC WATER LEVEL: 20 ft below land surface. Pump test data: Well water was N/A ft. after N/A hours pumping. EST. YIELD: gpm. Well water was ft. after hours pumping. Bore Hole Diameter: 6 in. to 7.0 ft. WELL WATER TO BE USED AS: [X] Monitoring well. Was a chemical/bacteriological sample submitted to Department? [X] No. Water well disinfected? [X] No

5 TYPE OF CASING USED: [X] PVC [ ] Steel [ ] Other. CASING JOINTS: [X] Threaded [ ] Glued [ ] Clamped [ ] Welded. Casing diameter: 2 in. to 7.0 ft. Casing height above land surface: 0.0 in. Weight: N/A lbs./ft. TYPE OF SCREEN OR PERFORATION MATERIAL: [X] PVC [ ] Steel [ ] Stainless Steel [ ] Brass [ ] Galvanized Steel [ ] None used (open hole). SCREEN OR PERFORATION OPENINGS ARE: [X] Other (specify) Factory Cut. SCREEN-PERFORATED INTERVALS: From 7.0 ft to 6.0 ft. GRAVEL PACK INTERVALS: From 7.0 ft to 5.0 ft.

6 GROUT MATERIAL: [X] Other (Best Portland Grout) [ ] Neat cement [ ] Cement grout [ ] Bentonite. Grout Intervals: From 5.0 ft to 0 ft. What is the nearest source of possible contamination: [X] Other (specify below) Ks River. Direction from well: N.E. Distance from well: 160 feet.

Table with 6 columns: FROM, TO, LITHOLOGIC LOG, FROM, TO, LITHO. LOG (cont.) or PLUGGING INTERVALS. Rows contain handwritten lithologic descriptions: 0-10 Rock with some clay, 10-30 Clay - Gravel - some clay, 30-55 Clay with sand, 55-70 Sand - wet w/ gravel.

7 CONTRACTOR'S OR LANDOWNER'S CERTIFICATION: This water well was [X] constructed, [ ] reconstructed, or [ ] plugged under my jurisdiction and was completed on (mo/day/year) 12/14/14. Kansas Water Well Contractor's License No. 793. This Water Well Record was completed on (mo/day/year) 1/5/15 under the business name of Cahoy Pump Service by (signature) [Signature]

INSTRUCTIONS: Use typewriter or ball point pen. PLEASE PRESS FIRMLY and PRINT clearly. Please fill in blanks and check the correct answers. Send one copy to Kansas Department of Health and Environment, Bureau of Water, Geology Section, 1000 SW Jackson St., Suite 420, Topeka, Kansas 66612-1367. Telephone 785-296-5524. Send one copy to WATER WELL OWNER and retain one for your records. Include fee of \$5.00 for each constructed well. Visit us at http://www.kdheks.gov/waterwell/index.html