

WATER WELL RECORD

Form WWC-5

Division of Water Resources App. No.


Well ID

MW2

Original Record Correction Change in Well Use

1 LOCATION OF WATER WELL: County Wyandotte Fraction SE 1/4 NW 1/4 SW 1/4 Section Number 3 Township Number T 11 S Range Number R 25 E

2 WELL OWNER: Last Name Kiayani First: A. Street or Rural Address where well is located (if unknown, distance and direction from nearest town or intersection): 748 Washington Blvd., Kansas City, KS

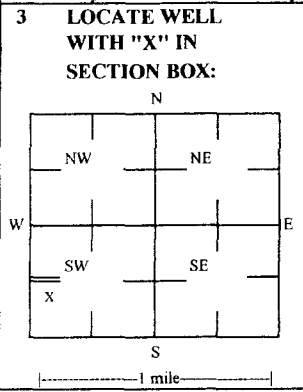

3 LOCATE WELL WITH 'X' IN SECTION BOX: 4 DEPTH OF COMPLETED WELL: 34.8 ft Depth(s) Groundwater Encountered: 1) 25.88 ft

5 Latitude: 39.11880 (decimal degrees) Longitude: 94.62915 (decimal degrees) Horizontal Datum: WGS 84 NAD 83 NAD 27

7 WELL WATER TO BE USED AS: 1 Domestic: Household, Lawn & Garden, Livestock, Irrigation, Feedlot, Industrial

Was a chemical/bacteriological sample submitted to KDHE? Yes No If yes, date sample was submitted:

8 TYPE OF CASING USED: Steel PVC Other CASING JOINTS: Glued Clamped Welded Threaded Casting diameter 2 in. to 14.8 ft.

9 GROUT MATERIAL: Neat cement Cement grout Bentonite Other Concrete: 0-1' Grout intervals: From 1 ft. to 13 ft.

Nearest source of possible contamination: Septic Tank Lateral Lines Pit Privy Livestock Pens Insecticide Storage

Table with columns: FROM, TO, LITHOLOGIC LOG, FROM, TO, LITHO. LOG (cont.) or PLUGGING INTERVALS. Rows show depth intervals and lithology like Concrete, Gray to brown silty clay, Brown silty clay, Brown to light brown silty clay, Brown sand w/ pebbles, Brown silty clay.

11 CONTRACTOR'S OR LANDOWNER'S CERTIFICATION: This water well was constructed, reconstructed, or plugged under my jurisdiction and was completed on (mo-day-year) 8/31/2015

DENNIS L. HANDKE

1820 NW 59th Terrace
TOPEKA, KANSAS 66618
785-286-4047 Home
785-286-1990 Fax

Jessica Chapman
Larsen & Associates
1311 E. 25th Street, Suite B
Lawrence, Kansas, 66046

October 26, 2015

RE: Monitor Well Elevation Survey
748 Washington Blvd., Kansas City, Kansas

Proj. 15-00PP
Snappy C-Store
KDHE ID U4-105-14678

Bench Mark: Square cut on SW corner of concrete sidewalk at SW Corner of building.
Elev: 852.71 North 815 West 2832 (from SE Cor. Sec.3-11-25E)

MW-1	rim	851.75	North	890	SE1/4,NW1/4,SW1/4,SW1/4
	top pipe	851.19	West	5854	Lat= 39.11901 Long = 94.62919
MW-2	rim	852.18	North	814	SE1/4,NW1/4,SW1/4,SW1/4
	top pipe	851.72	West	4846	Lat= 39.11880 Long = 94.62915
MW-3	rim	842.86	North	981	SE1/4,NW1/4,SW1/4,SW1/4
	top pipe	842.54	West	4870	Lat= 39.11926 Long = 94.62926
MW-4	rim	849.09	North	859	SW1/4,NW1/4,SW1/4,SW1/4
	top pipe	848.81	West	5006	Lat= 39.11890 Long = 94.62972
MW-5	rim	836.47	North	912	SE1/4,NW1/4,SW1/4,SW1/4
	top pipe	836.13	West	4745	Lat= 39.11909 Long = 94.62881
MW-6	rim	852.75	North	776	SE1/4,NW1/4,SW1/4,SW1/4
	top pipe	852.42	West	4799	Lat= 39.11870 Long = 94.62898

Elevation derived from USGS BM R281 NAVD 88

Lat & Long derived from Shawnee 7.5 Quad Map WSG84

If you have any questions, please feel free to call me. Thank you for the opportunity to be of service to you.

Dennis L Handke RLS

