

WATER WELL RECORD

Form WWC-5

Division of Water Resources App. No.


Well ID

MW3

Original Record Correction Change in Well Use

1 LOCATION OF WATER WELL: County Wyandotte Fraction SE 1/4 NW 1/4 SW 1/4 SW 1/4 Section Number 3 Township Number T 11 S Range Number R 25 E W

2 WELL OWNER: Last Name Kiayani First: A. Street or Rural Address where well is located (if unknown, distance and direction from nearest town or intersection): If at owner's address, check here: ~75' N of 748 Washington Blvd., Kansas City, KS

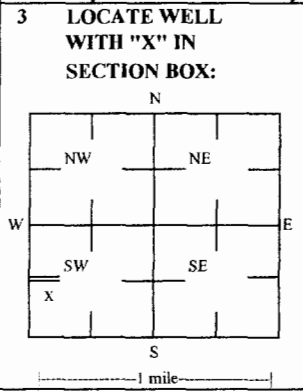

3 LOCATE WELL WITH 'X' IN SECTION BOX: 4 DEPTH OF COMPLETED WELL: 28.83 ft. WELL'S STATIC WATER LEVEL: 21.7 ft. below land surface, measured on (mo-day-yr) 9/30/2015

5 Latitude: 39.11926 (decimal degrees) Longitude: 94.62926 (decimal degrees) Horizontal Datum: WGS 84 NAD 83 NAD 27

6 Elevation 842.54 ft Ground Level TOC Source Land Survey GPS Topographic Map

7 WELL WATER TO BE USED AS: 1 Domestic: Household, Lawn & Garden, Livestock, Irrigation, Feedlot, Industrial. 5 Public Water Supply: well ID. 8 Monitoring: well ID MW3. 10 Oil Field Water Supply: lease. 11 Test Hole: well ID. 12 Geothermal: How many bores?

Was a chemical/bacteriological sample submitted to KDHE? Yes No If yes, date sample was submitted:

8 TYPE OF CASING USED: Steel PVC Other CASING JOINTS: Glued Clamped Welded Threaded. TYPE OF SCREEN OR PERFORATION MATERIAL: Steel Stainless Steel Fiberglass PVC Other (Specify). SCREEN OR PERFORATION OPENINGS ARE: Continuous Slot Mill Slot Gauze Wrapped Torch Cut Drilled Holes Other (Specify).

9 GROUT MATERIAL: Neat cement Cement grout Bentonite Other Concrete: 0-1' Grout intervals: From 1 ft. to 7 ft.

Nearest source of possible contamination: Septic Tank Lateral Lines Pit Privy Livestock Pens Insecticide Storage Sewer Lines Cess Pool Sewage Lagoon Fuel Storage Abandoned Water Well Watertight Sewer Lines Seepage Pit Feedyard Fertilizer Storage Oil Well / Gas Well

Direction from well? S Distance from well? ~100' ft

Table with columns FROM, TO, LITHOLOGIC LOG, FROM, TO, LITHO. LOG (cont.) or PLUGGING INTERVALS. Rows show depth intervals from 0 to 29.2 ft with descriptions like Asphalt and gravel, Gray & brown silty clay, etc.

Notes: KDHE ID: Snappy C-Store; U4-105-14678

11 CONTRACTOR'S OR LANDOWNER'S CERTIFICATION: This water well was constructed, reconstructed, or plugged under my jurisdiction and was completed on (mo-day-year) 9/1/2015 and this record is true to the best of my knowledge and belief.

# DENNIS L. HANDKE

1820 NW 59th Terrace  
TOPEKA, KANSAS 66618  
785-286-4047 Home  
785-286-1990 Fax

Jessica Chapman  
Larsen & Associates  
1311 E. 25<sup>th</sup> Street, Suite B  
Lawrence, Kansas, 66046

October 26, 2015

RE: Monitor Well Elevation Survey  
748 Washington Blvd., Kansas City, Kansas

Proj. 15-00PP  
Snappy C-Store  
KDHE ID U4-105-14678

Bench Mark: Square cut on SW corner of concrete sidewalk at SW Corner of building.  
Elev: 852.71      North 815      West 2832      (from SE Cor. Sec.3-11-25E)

MW-1	rim	851.75	North	890	SE1/4,NW1/4,SW1/4,SW1/4
	top pipe	851.19	West	5854	Lat= 39.11901 Long = 94.62919
MW-2	rim	852.18	North	814	SE1/4,NW1/4,SW1/4,SW1/4
	top pipe	851.72	West	4846	Lat= 39.11880 Long = 94.62915
MW-3	rim	842.86	North	981	SE1/4,NW1/4,SW1/4,SW1/4
	top pipe	842.54	West	4870	Lat= 39.11926 Long = 94.62926
MW-4	rim	849.09	North	859	SW1/4,NW1/4,SW1/4,SW1/4
	top pipe	848.81	West	5006	Lat= 39.11890 Long = 94.62972
MW-5	rim	836.47	North	912	SE1/4,NW1/4,SW1/4,SW1/4
	top pipe	836.13	West	4745	Lat= 39.11909 Long = 94.62881
MW-6	rim	852.75	North	776	SE1/4,NW1/4,SW1/4,SW1/4
	top pipe	852.42	West	4799	Lat= 39.11870 Long = 94.62898

Elevation derived from USGS BM R281    NAVD 88

Lat & Long derived from Shawnee 7.5 Quad Map WSG84

If you have any questions, please feel free to call me. Thank you for the opportunity to be of service to you.

Dennis L Handke RLS

