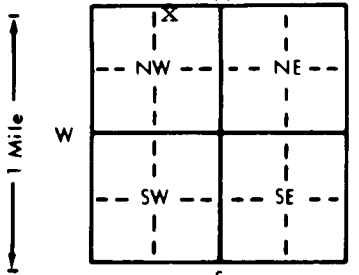


1 LOCATION OF WATER WELL: County: Wyandotte		Fraction NW ¼ NE ¼ NW ¼		Section Number 2	Township Number T 11 S	Range Number R 25E 3W																																				
Distance and direction from nearest town or city street address of well if located within city? 2029 Fairfax Trafficway, Kansas City, KS 66115	
2 WATER WELL OWNER: Phillips Pipeline RR#, St. Address, Box #: P. O. Box 1035 City, State, ZIP Code: Kansas City, KS 66115 Board of Agriculture, Division of Water Resources Application Number:	
3 LOCATE WELL'S LOCATION WITH AN "X" IN SECTION BOX: <div style="text-align: center;"></div>		4 DEPTH OF COMPLETED WELL: 56'4" ft. ELEVATION: --- Depth(s) Groundwater Encountered 1. --- ft. 2. --- ft. 3. --- ft. WELL'S STATIC WATER LEVEL 20 ft. below land surface measured on mo/day/yr 7/9/90 Pump test data: Well water was --- ft. after --- hours pumping --- gpm Est. Yield --- gpm: Well water was --- ft. after --- hours pumping --- gpm Bore Hole Diameter 36 in. to 56'4" ft. and --- in. to --- ft. WELL WATER TO BE USED AS: 1 Domestic 3 Feedlot 5 Public water supply 8 Air conditioning 11 Injection well 2 Irrigation 4 Industrial 6 Oil field water supply 9 Dewatering 12 Other (Specify below) 7 Lawn and garden only 10 Monitoring well Was a chemical/bacteriological sample submitted to Department? Yes --- No ---; If yes, mo/day/yr sample was submitted Water Well Disinfected? Yes --- No ---	
5 TYPE OF BLANK CASING USED: 1 Steel 3 RMP (SR) 5 Wrought iron 8 Concrete tile CASING JOINTS: Glued --- Clamped --- 2 PVC 4 ABS 6 Asbestos-Cement 9 Other (specify below) Welded X Threaded --- Blank casing diameter 20 in. to 36'4" ft., Dia. --- in. to --- ft., Dia. --- in. to --- ft. Casing height above land surface 42 in., weight --- lbs./ft. Wall thickness or gauge No. 0.375 TYPE OF SCREEN OR PERFORATION MATERIAL: 1 Steel 3 Stainless steel 5 Fiberglass 7 PVC 10 Asbestos-cement 2 Brass 4 Galvanized steel 6 Concrete tile 8 RMP (SR) 11 Other (specify) --- 9 ABS 12 None used (open hole) SCREEN OR PERFORATION OPENINGS ARE: 1 Continuous slot 3 Mill slot 5 Gauzed wrapped 8 Saw cut 11 None (open hole) 2 Louvered shutter 4 Key punched 6 Wire wrapped 9 Drilled holes 7 Torch cut 10 Other (specify) --- SCREEN-PERFORATED INTERVALS: From 36'4" ft. to 56'4" ft., From --- ft. to --- ft. GRAVEL PACK INTERVALS: From 14'0" ft. to 56'4" ft., From --- ft. to --- ft. From --- ft. to --- ft., From --- ft. to --- ft.	
6 GROUT MATERIAL: 1 Neat cement 2 Cement grout 3 Bentonite 4 Other --- Grout Intervals: From 0 to 12 ft., From 12 to 14 ft., From --- ft. to --- ft. What is the nearest source of possible contamination: 1 Septic tank 4 Lateral lines 7 Pit privy 10 Livestock pens 14 Abandoned water well 2 Sewer lines 5 Cess pool 8 Sewage lagoon 11 Fuel storage 15 Oil well/Gas well 3 Watertight sewer lines 6 Seepage pit 9 Feedyard 12 Fertilizer storage 16 Other (specify below) 13 Insecticide storage Direction from well? North How many feet? 50'± <table border="1" style="width:100%"><thead><tr><th>FROM</th><th>TO</th><th>LITHOLOGIC LOG</th><th>FROM</th><th>TO</th><th>PLUGGING INTERVALS</th></tr></thead><tbody><tr><td>0</td><td>2'6"</td><td>Portland cement grout</td><td></td><td></td><td></td></tr><tr><td>2'6"</td><td>3'0"</td><td>Bentonite</td><td></td><td></td><td></td></tr><tr><td>3'0"</td><td>20'0"</td><td>Portland cement grout</td><td></td><td></td><td></td></tr><tr><td>20'0"</td><td>56'4"</td><td>Chlorinated sand</td><td></td><td></td><td></td></tr><tr><td></td><td></td><td>Steel casing (20" ø) was cut off flush w/the ground surface.</td><td></td><td></td><td>Steel casing not cut off 3' below ground due to grout collar around outside of casing.</td></tr>
7 CONTRACTOR'S OR LANDOWNER'S CERTIFICATION: This water well was (1) constructed, (2) reconstructed, or (3) plugged under my jurisdiction and was completed on (mo/day/year) 7/9/90 and this record is true to the best of my knowledge and belief. Kansas Water Well Contractor's License No. 102 This Water Well Record was completed on (mo/day/yr) 10/10/90 under the business name of Layne-Western Company, Inc. by (signature) Paul W. Smith	