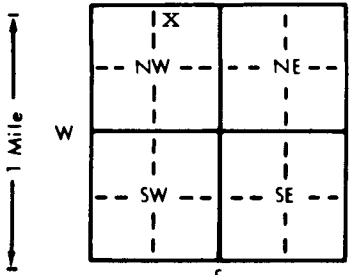


1 LOCATION OF WATER WELL: County: Wyandotte		Fraction NW ¼ NE ¼ NW ¼		Section Number 2	Township Number T 11 S	Range Number R 25 E <u>2W</u>
Distance and direction from nearest town or city street address of well if located within city? 2029 Fairfax Trafficway, Kansas City, KS 66115						
2 WATER WELL OWNER: Phillips Pipeline RR#, St. Address, Box # : P. O. Box 1035 City, State, ZIP Code : Kansas City, KS 66115 Board of Agriculture, Division of Water Resources Application Number:						
3 LOCATE WELL'S LOCATION WITH AN "X" IN SECTION BOX: <div style="text-align: center;"></div>		4 DEPTH OF COMPLETED WELL: 56'4" ft. ELEVATION: --- Depth(s) Groundwater Encountered 1. --- ft. 2. --- ft. 3. --- ft. WELL'S STATIC WATER LEVEL 20 ft. below land surface measured on mo/day/yr 7/9/90 Pump test data: Well water was --- ft. after --- hours pumping --- gpm Est. Yield --- gpm: Well water was --- ft. after --- hours pumping --- gpm Bore Hole Diameter 36 in. to 56'4" ft., and --- in. to --- ft. WELL WATER TO BE USED AS: 1 Domestic 3 Feedlot 5 Public water supply 8 Air conditioning 11 Injection well 2 Irrigation 4 Industrial 6 Oil field water supply 9 Dewatering 12 Other (Specify below) 7 Lawn and garden only 10 Monitoring well Was a chemical/bacteriological sample submitted to Department? Yes --- No --- If yes, mo/day/yr sample was submitted Water Well Disinfected? Yes --- No ---				
5 TYPE OF BLANK CASING USED: 1 Steel 3 RMP (SR) 5 Wrought iron 8 Concrete tile CASING JOINTS: Glued --- Clamped --- 2 PVC 4 ABS 6 Asbestos-Cement 9 Other (specify below) Welded --- Blank casing diameter 2 in. to 13 in. ft., Dia --- in. to --- ft., Dia --- in. to --- ft. Casing height above land surface 36 in., weight --- lbs./ft. Wall thickness or gauge No. Sch. 40 TYPE OF SCREEN OR PERFORATION MATERIAL: 1 Steel 3 Stainless steel 5 Fiberglass 8 RMP (SR) 10 Asbestos-cement 2 Brass 4 Galvanized steel 6 Concrete tile 9 ABS 11 Other (specify) --- 12 None used (open hole) --- SCREEN OR PERFORATION OPENINGS ARE: 1 Continuous slot 3 Mill slot 5 Gauzed wrapped 8 Saw cut 11 None (open hole) 2 Louvered shutter 4 Key punched 6 Wire wrapped 9 Drilled holes 7 Torch cut 10 Other (specify) --- SCREEN-PERFORATED INTERVALS: From 36'4" ft. to 56'4" ft., From --- ft. to --- ft. GRAVEL PACK INTERVALS: From 14'0" ft. to 56'4" ft., From --- ft. to --- ft. From --- ft. to --- ft., From --- ft. to --- ft.						
6 GROUT MATERIAL: 1 Neat cement 2 Cement grout 3 Bentonite 4 Other --- Grout Intervals: From 0 ft. to 14 ft., From --- ft. to --- ft., From --- ft. to --- ft. What is the nearest source of possible contamination: 1 Septic tank 4 Lateral lines 7 Pit privy 10 Livestock pens 14 Abandoned water well 2 Sewer lines 5 Cess pool 8 Sewage lagoon 11 Fuel storage 15 Oil well/Gas well 3 Watertight sewer lines 6 Seepage pit 9 Feedyard 12 Fertilizer storage 16 Other (specify below) 13 Insecticide storage --- Direction from well? How many feet? FROM TO LITHOLOGIC LOG FROM TO PLUGGING INTERVALS						
0	2'6"	Portland cement grout w/ bentonite				
2'6"	3'0"	Bentonite				
3'0"	20'0"	Portland cement grout w/ bentonite				
20'0"	56'4"	Chlorinated sand				
		Steel casing cut off flush w/ surface due to presence of grout collar around casing				
7 CONTRACTOR'S OR LANDOWNER'S CERTIFICATION: This water well was (1) constructed, (2) reconstructed, or (3) plugged under my jurisdiction and was completed on (mo/day/year) 7/9/90 and this record is true to the best of my knowledge and belief. Kansas Water Well Contractor's License No. 102 This Water Well Record was completed on (mo/day/yr) 10/10/90 under the business name of Layne-Western Company, Inc. by (signature) Paul W. Fomela						

INSTRUCTIONS: Use typewriter or ball point pen. PLEASE PRESS FIRMLY and PRINT clearly. Please fill in blanks, underline or circle the correct answers. Send top three copies to Kansas Department of Health and Environment, Bureau of Water, Topeka, Kansas 66620-7320. Telephone: 913-296-5545. Send one to WATER WELL OWNER and retain one for your records.