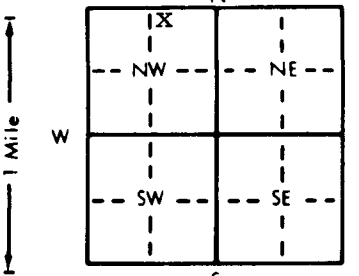


1 LOCATION OF WATER WELL:		Fraction	Section Number	Township Number	Range Number
County: Wyandotte		NW 1/4 NE 1/4 NW 1/4	2	T 11 S	R 25 E X/W
Distance and direction from nearest town or city street address of well if located within city? 2029 Fairfax Trafficway, Kansas City, Kansas 66115					
2 WATER WELL OWNER: Phillips Pipeline RR#, St. Address, Box # : P. O. Box 1035 City, State, ZIP Code : Kansas City, KS 66115 Board of Agriculture, Division of Water Resources Application Number:					
3 LOCATE WELL'S LOCATION WITH AN "X" IN SECTION BOX:		4 DEPTH OF COMPLETED WELL 38.0 ft. ELEVATION: .ft.			
<div style="text-align: center;"></div>		Depth(s) Groundwater Encountered 1. 20 ft. 2. .ft. 3. .ft.			
		WELL'S STATIC WATER LEVEL 20 ft. below land surface measured on mo/day/yr			
		Pump test data: Well water was .ft. after .hours pumping .gpm			
		Est. Yield .gpm: Well water was .ft. after .hours pumping .gpm			
Bore Hole Diameter 24 in. to 38 ft., and .in. to .ft.		WELL WATER TO BE USED AS:			
1 Domestic		3 Feedlot	5 Public water supply	8 Air conditioning	11 Injection well
2 Irrigation		4 Industrial	6 Oil field water supply	9 Dewatering	12 Other (Specify below)
3 Lawn and garden only		7 Monitoring well	Was a chemical/bacteriological sample submitted to Department? Yes.....No.....; If yes, mo/day/yr sample was submitted		
Water Well Disinfected? Yes No					
5 TYPE OF BLANK CASING USED:					
1 Steel		3 RMP (SR)	5 Wrought iron	8 Concrete tile	CASING JOINTS: Glued .Clamped .
2 PVC		4 ABS	6 Asbestos-Cement	9 Other (specify below)	Welded .X. Threaded .
Blank casing diameter 8 in. to 13 ft., Dia		7 Fiberglass			
Casing height above land surface 36 in., weight		lbs./ft. Wall thickness or gauge No.			
TYPE OF SCREEN OR PERFORATION MATERIAL:					
1 Steel		3 Stainless steel	5 Fiberglass	7 PVC	10 Asbestos-cement
2 Brass		4 Galvanized steel	6 Concrete tile	8 RMP (SR)	11 Other (specify)
SCREEN OR PERFORATION OPENINGS ARE:		5 Gauzed wrapped	8 Saw cut	11 None (open hole)	
1 Continuous slot		3 Mill slot	6 Wire wrapped	9 Drilled holes	
2 Louvered shutter		4 Key punched	7 Torch cut	10 Other (specify)	
SCREEN-PERFORATED INTERVALS: From 13 ft. to 38 ft., From .ft. to .ft.					
GRAVEL PACK INTERVALS: From 11 ft. to 38 ft., From .ft. to .ft.					
6 GROUT MATERIAL: 1 Neat cement 2 Cement grout 3 Bentonite 4 Other					
Grout Intervals: From 0 ft. to 10 ft., From 10 ft. to 11 ft., From .ft. to .ft.					
What is the nearest source of possible contamination:					
1 Septic tank		4 Lateral lines	7 Pit privy	10 Livestock pens	14 Abandoned water well
2 Sewer lines		5 Cess pool	8 Sewage lagoon	11 Fuel storage	15 Oil well/Gas well
3 Watertight sewer lines		6 Seepage pit	9 Feedyard	12 Fertilizer storage	16 Other (specify below)
Direction from well? North		How many feet? 50'±			
FROM	TO	LITHOLOGIC LOG	FROM	TO	PLUGGING INTERVALS
0	2'6"	Cement grout			Steel casing cut off flush w/surface due to grout collar around outside of casing.
2'6"	3'0"	Bentonite			
3'0"	20'0"	Cement grout			
20'0"	38'0"	Chlorinated sand			
7 CONTRACTOR'S OR LANDOWNER'S CERTIFICATION: This water well was (1) constructed, (2) reconstructed, or (3) plugged under my jurisdiction and was completed on (mo/day/year) 7/9/90 and this record is true to the best of my knowledge and belief. Kansas Water Well Contractor's License No. 102 This Water Well Record was completed on (mo/day/yr) 10/10/90 under the business name of Layne-Western Company, Inc. by (signature) Paul W. Farnham					
INSTRUCTIONS: Use typewriter or ball point pen. PLEASE PRESS FIRMLY and PRINT clearly. Please fill in blanks, underline or circle the correct answers. Send top three copies to Kansas Department of Health and Environment, Bureau of Water, Topeka, Kansas 66620-7320. Telephone: 913-296-5545. Send one to WATER WELL OWNER and retain one for your records.					