

mw-17B

WATER WELL PLUGGING RECORD Form WWC-5P KSA 82a-1212 ID NO.

1 LOCATION OF WATER WELL: County: Wyandotte Fraction 1/4 SW 1/4 SW 1/4 SW 1/4 Section Number 6 Township Number T 11 S Range Number 25 [X] E [] W


Street/Rural Address of Well Location; if unknown, distance & direction from nearest town or intersection: If at owner's address, check here [] 4626 State Ave.; Kansas City, KS

Global Positioning Systems (GPS) information: Latitude: 39.11701 (in decimal degrees) Longitude: 94.68582 (in decimal degrees) Elevation: 895 Horizontal Datum: [X] WGS84, [] NAD83, [] NAD27 Collection Method:

2 WATER WELL OWNER: Atlantic Richfield Co. RR#, St. Address, Box #: 501 Westlake Park Blvd. City, State ZIP Code: Houston, TX 77079

[X] GPS unit (Make/Model: Garmin etrek) [] Digital Map/Photo, [] Topographic Map, [] Land Survey Est. Accuracy: [X] < 3 m, [] 3-5 m, [] 5-15 m, [] > 15 m

3 MARK WELL'S LOCATION WITH AN "X" IN SECTION BOX:

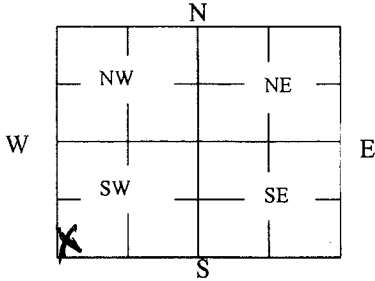

4 DEPTH OF WELL 42 ft.

WELL'S STATIC WATER LEVEL 17.22 ft

WELL WAS USED AS:

- [] Domestic [] Public Water Supply [] Dewatering
[] Irrigation [] Oil Field Water Supply [X] Monitoring
[] Feedlot [] Domestic (Lawn & Garden) [] Injection Well
[] Industrial [] Air Conditioning [] Other

Was a chemical/bacteriological sample submitted to Department? Yes [] No [X]

5 TYPE OF BLANK CASING USED:

- [X] Steel [] RMP (SR) [] Wrought [] Fiberglass [] Other (Specify below)
[] PVC [] ABS [] Asbestos-Cement [] Concrete Tile

Blank casing diameter 2 in. Was casing pulled? Yes [X] No [] If yes, how much all
Casing height above or below land surface -6 in.

6 GROUT PLUG MATERIAL: [] Neat cement [] Cement grout [X] Bentonite [] Other

Grout Plug Intervals: From 0 ft. to 3 ft., From 3 ft. to 42 ft., From ft. to ft.

What is the nearest source of possible contamination:

- [] Septic tank [] Seepage pit [X] Fuel storage [] Other (specify below)
[] Sewer lines [] Pit privy [] Fertilizer storage
[] Watertight sewer lines [] Sewage lagoon [] Insecticide storage
[] Lateral lines [] Feedyard [] Abandoned water well Direction from well?
[] Cess pool [] Livestock pens [] Oil well/Gas well How many feet?

Table with 6 columns: FROM, TO, PLUGGING MATERIALS, FROM, TO, PLUGGING MATERIALS. Row 1: 0, 3, empty, empty, empty, empty. Row 2: 3, 42, Bentonite, empty, empty, empty.

7 CONTRACTOR'S OR LANDOWNER'S CERTIFICATION: This water well was plugged under my jurisdiction and was completed on (mo/day/year) 10/26/2016 10/27/16 and this record is true to the best of my knowledge and belief. Kansas Water Well Contractor's License No. 710. This Water Well Record was completed on (mo/day/year) 10/28/2016 under the business name of Below Ground Surface, Inc. by (signature)

Send one white copy to Kansas Department of Health & Environment, Geology Section, 1000 SW Jackson Street, Ste. 420, Topeka, KS 66612-1367. Send one copy to WATER WELL OWNER and retain one for your records. Visit us at http://www.kdheks.gov/waterwell/index.html Telephone 785-296-5524.