

WATER WELL RECORD

DRILLERS LOG OF WELL

FROM (FT.)	TO (FT.)	KIND OF MATERIAL, COLOR, ETC. (NOTE WATER ZONES, AMOUNT, QUALITY)
0	4	Top Soil
4	34	Sandstone
34	39	lime
39	49	Shale
49	61	Lime Broken Water
61	67	Shale Dark
67	73	lime
73	82	Shale
82	92	lime sandy
92	100	lime T. A soft.

Well Owner M. Guy O. Bond
 Address 1945 W. 26th - K.C.K.
 Drilling Contractor Brown Drilling Co
Box 147 - Berwyn, Kansas
 Date Drilled 3-1-63
 Method of Drilling Cable Tool's
(Cable tool, rotary, reverse rotary, etc.)
 Casing Schedule 11 ft 8" used
(Amount, Size, Setting—New, Used—Steel, Galv.—Gage or Weight)

Screen Data (if any): _____
(Length, Diameter, Slot Size, Setting)


Measured depth to water on completed well (Static Level) is
50 ft. below land surface
(Land Surface, Top of Casing, Etc.)

TESTED YIELD: 3 gallons per min
(Min., Hour)
 as determined by Bailing
(Bailing, Test Pumping, Etc.)

DRAWDOWN: _____ ft. after _____ hrs.
 pumping at _____ gal. per minute.

REMARKS:

LOCATION OF WELL Topographic Sheet _____
[Show location in Section Plat] Elev. _____

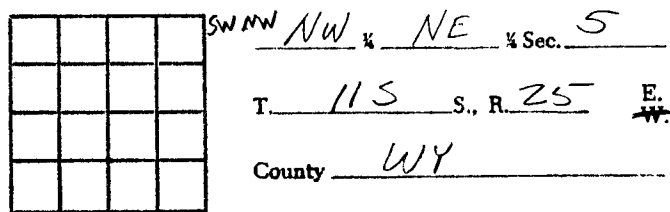

"To preserve water well information and to promote the conservation, protection, and development of ground-water resources."