


1 LOCATION OF WATER WELL: Fraction 1/4 SW 1/4 SW 1/4 SW 1/4 Section Number 18 Township Number T 11 S Range Number 25 E W
 County: Wyandotte

Street/Rural Address of Well Location; if unknown, distance & direction from nearest town or intersection: If at owner's address, check here Argentine Rail yard; Kansas City, KS

Global Positioning Systems (GPS) information:
 Latitude: 39.08911 (in decimal degrees)
 Longitude: -94.68630 (in decimal degrees)
 Elevation: _____
 Horizontal Datum: WGS84, NAD83, NAD27
 Collection Method: _____

2 WATER WELL OWNER: BNSF Railway
 RR#, St. Address, Box #: 4515 Kansas Ave.
 City, State ZIP Code: Kansas City, KS 66106

GPS unit (Make/Model: Garmin etrek)
 Digital Map/Photo, Topographic Map, Land Survey
 Est. Accuracy: < 3 m. 3-5 m. 5-15 m. > 15 m

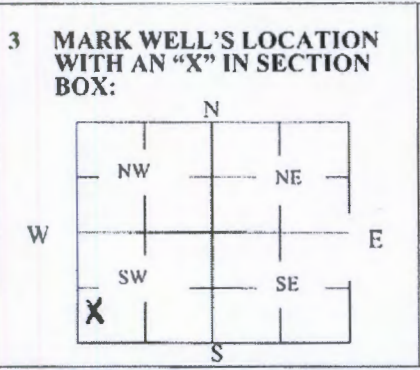

4 DEPTH OF WELL 45 ft.
 WELL'S STATIC WATER LEVEL _____ ft. MW04-1
 WELL WAS USED AS:
 Domestic Public Water Supply Dewatering
 Irrigation Oil Field Water Supply Monitoring
 Feedlot Domestic (Lawn & Garden) Injection Well
 Industrial Air Conditioning Other _____
 Was a chemical/bacteriological sample submitted to Department? Yes No

5 TYPE OF BLANK CASING USED:

Steel RMP (SR) Wrought Fiberglass Other (Specify below)
 PVC ABS Asbestos-Cement Concrete Tile

Blank casing diameter 2 in. Was casing pulled? Yes No If yes, how much all _____
 Casing height above or below land surface 0 in.

6 GROUT PLUG MATERIAL: Neat cement Cement grout Bentonite Other Top Soil

Grout Plug Intervals: From 0 ft. to 3 ft., From 3 ft. to 45 ft., From _____ ft. to _____ ft.

What is the nearest source of possible contamination:
 Septic tank Seepage pit Fuel storage Other (specify below)
 Sewer lines Pit privy Fertilizer storage
 Watertight sewer lines Sewage lagoon Insecticide storage
 Lateral lines Feedyard Abandoned water well
 Cess pool Livestock pens Oil well/Gas well
 Direction from well? Unknown
 How many feet? _____

FROM	TO	PLUGGING MATERIALS	FROM	TO	PLUGGING MATERIALS
0	3	Top Soil			
3		Bentonite			

7 CONTRACTOR'S OR LANDOWNER'S CERTIFICATION: This water well was plugged under my jurisdiction and was completed on (mo/day/year) 4/11/2017 and this record is true to the best of my knowledge and belief. Kansas Water Well Contractor's License No. 710. This Water Well Record was completed on (mo/day/year) 5/5/2017 under the business name of Below Ground Surface, Inc. by (signature) _____

Send one white copy to Kansas Department of Health & Environment, Geology Section, 1000 SW Jackson Street, Ste. 420, Topeka, KS 66612-1367. Send one copy to WATER WELL OWNER and retain one for your records.
 Visit us at <http://www.kdheks.gov/waterwell/index.html> Telephone 785-296-5524.



NOTES

- 1) Results are displayed in micrograms per liter (µg/L).
- 2) NS = Not Sampled
- 3) NA = Not Analyzed
- 4) LNAPL = Light Non-Volatile Phase Liquid
- 5) KDHE = Kansas Department of Health and Environment
- 6) RSK = Risk-Based Standards for Kansas
- 7) TPH = Total Petroleum Hydrocarbons
- 8) DRD = Diesel Range Organics
- 9) MRH = Mid-Range Hydrocarbons
- 10) HRH = High-Range Hydrocarbons

SCALE IN FEET

0 180 360

KWHE Non-Residential		MW-1	
Tier 2 RSK (µg/L)		Date	10/2013
Benzene	5	Groswater Result (µg/L)	
Napthalene	2.11	Groswater Result (µg/L)	
TPH DRD	720	Groswater Result (µg/L)	
MRH	400	Groswater Result (µg/L)	
HRH	2,500	Groswater Result (µg/L)	

- Legend**
- Monitoring Well
 - Proposed Shallow SVE Well
 - Proposed Deep SVE Well
 - Proposed Pilot Test Shallow Observation Well
 - Proposed Pilot Test Deep Observation Well
 - Proposed Air Sparge Well
 - Groundwater Exceeds KDHE Non-Residential Tier 2 RSK Value
 - Railroad Overpass
 - Buildings
 - Source Area
 - VCP Project Area
 - Groundwater Result Exceeds Applicable KDHE Tier 2 RSK Non-Residential Scenario Groundwater Screening Level
 - Light Non-Aqueous Phase Liquid (LNAPL) Detected on At Least One Occasion