


#2

WATER WELL PLUGGING RECORD Form WWC-5P KSA 82a-1212 ID NO. []

1 LOCATION OF WATER WELL: County: Wyandotte Fraction SE 1/4 SW 1/4 SE 1/4 Section Number 15 Township Number 11 Range Number 25 EW

Distance and direction from nearest town or city street address of well if located within city? owners info: James P. Barry; Kansas Ave Prop. LLC; 3840 W. 139th Terr. KS. Leawood

2 WATER WELL OWNER: James P. Barry Site RR#, St. Address, Box #: 51 Kansas Ave. City, State ZIP Code: Kansas City, KS. Global Positioning Systems (decimal degrees, min. of 4 digits Latitude: 39 05 15.96 Longitude: 94 37 00.82 Elevation: Datum: Data Collection Method: Google Earth

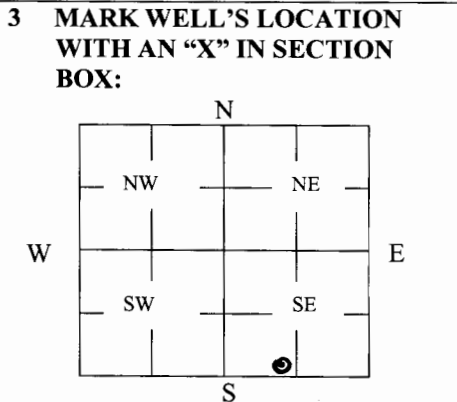

3 MARK WELL'S LOCATION WITH AN "X" IN SECTION BOX: 4 DEPTH OF WELL 35' ft. WELL'S STATIC WATER LEVEL 26.89 ft. WELL WAS USED AS: 1 Domestic 2 Irrigation 3 Feedlot 4 Industrial 5 Public Water Supply 6 Oil Field Water Supply 7 Domestic (Lawn & Garden) 8 Air Conditioning 9 Dewatering 10 Monitoring 11 Injection Well 12 Other Was a chemical/bacteriological sample submitted to Department? Yes No X

5 TYPE OF BLANK CASING USED: 1 Steel 2 PVC 3 RMP (SR) 4 ABS 5 Wrought 6 Asbestos-Cement 7 Fiberglass 8 Concrete Tile 9 Other (Specify below) Blank casing diameter 2" in. Was casing pulled? Yes X No If yes, how much 35' Casing height above or below land surface in.

6 GROUT PLUG MATERIAL: 1 Neat cement 2 Cement grout 3 Bentonite 4 Other Asphalt Grout Plug Intervals: From 35' ft. to 1' ft., From 1' to 0' ft. What is the nearest source of possible contamination: 1 Septic tank 2 Sewer lines 3 Watertight sewer lines 4 Lateral lines 5 Cess pool 6 Seepage pit 7 Pit privy 8 Sewage lagoon 9 Feedyard 10 Livestock pens 11 Fuel Storage 12 Fertilizer storage 13 Insecticide storage 14 Abandoned water well 15 Oil well/Gas well 16 Other (specify below) Direction from well? East How many feet? 20'

Table with columns: FROM, TO, PLUGGING MATERIALS. Handwritten entries: Flush Mt. Manure was removed, 2" PVC pipe was pulled out to T.D., Bentonite from 35'-1', Asphalt 1'-0'

7 CONTRACTOR'S OR LANDOWNER'S CERTIFICATION: This water well was plugged under my jurisdiction and was completed on (mo/day/year) 4/9/18 and this record is true to the best of my knowledge and belief. Kansas Water Well Contractor's License No. 432 This Water Well Record was completed on (mo/day/year) 4/21/18 under the business name of JB Environmental by (signature) James Bukel

INSTRUCTIONS: Use typewriter or ballpoint pen. Please press firmly and print clearly. Please fill in blanks, underline or circle the correct answers. Send top three copies to Kansas Department of Health and Environment, Bureau of Water, Geology Section, 1000 SW Jackson St., Ste. 420, Topeka, Kansas 66612-1367. Telephone: 785/296-5522. Send one to Water Well Owner and retain one for your records. Visit us at http://www.kdheks.gov/geo/waterwells.