


WATER WELL PLUGGING RECORD Form WWC-5P KSA 82a-1212 ID NO. []

| | | | | |
|---|---------------------------------------|---------------------------|----------------------------|---|
| 1 LOCATION OF WATER WELL: County: <u>Wyandotte</u> | Fraction: <u>SE 1/4 SW 1/4 SE 1/4</u> | Section Number: <u>15</u> | Township Number: <u>11</u> | Range Number: <u>25</u> <input checked="" type="radio"/> BW |
|---|---------------------------------------|---------------------------|----------------------------|---|

Distance and direction from nearest town or city street address of well if located within city?
 owner info: James P. Barry; Kansas Ave Prop. LLC. 3840 W. 139th. Terr Leawood, Ks. 66224

| | |
|---|--|
| 2 WATER WELL OWNER: <u>James P. Barry</u> RR#, St. Address, Box #: <u>Site 51 Kansas Ave.</u> City, State ZIP Code: <u>Kansas City, Ks.</u> | Global Positioning Systems (decimal degrees, min. of 4 digits) Latitude: <u>39 05 15.83</u> Longitude: <u>94 37 00.05</u> Elevation: _____ Datum: _____ Data Collection Method: <u>Google Earth</u> |
|---|--|

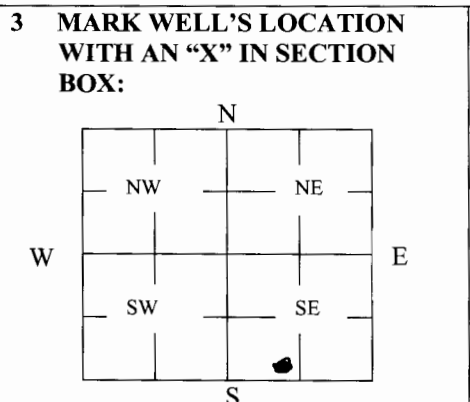

4 DEPTH OF WELL 35' ft.
 WELL'S STATIC WATER LEVEL 26.51 ft.
 WELL WAS USED AS:
 1 Domestic 5 Public Water Supply 9 Dewatering
 2 Irrigation 6 Oil Field Water Supply 10 Monitoring
 3 Feedlot 7 Domestic (Lawn & Garden) 11 Injection Well
 4 Industrial 8 Air Conditioning 12 Other _____
 Was a chemical/bacteriological sample submitted to Department? Yes _____ No

5 TYPE OF BLANK CASING USED:
 1 Steel 3 RMP (SR) 5 Wrought 7 Fiberglass 9 Other (Specify below)
 PVC 4 ABS 6 Asbestos-Cement 8 Concrete Tile

Blank casing diameter 2" in. Was casing pulled? Yes No _____ If yes, how much Total Depth
 Casing height above or below land surface N/A in.

6 GROUT PLUG MATERIAL: 1 Neat cement 2 Cement grout 3 Bentonite 4 Other Asphalt

Grout Plug Intervals: From 35' ft. to 1' ft., From _____ ft. to _____ ft., From 1' to 0' ft.

What is the nearest source of possible contamination:
 1 Septic tank 6 Seepage pit 11 Fuel Storage 16 Other (specify below)
 2 Sewer lines 7 Pit privy 12 Fertilizer storage
 3 Watertight sewer lines 8 Sewage lagoon 13 Insecticide storage
 4 Lateral lines 9 Feedyard 14 Abandoned water well Direction from well? west
 5 Cess pool 10 Livestock pens 15 Oil well/Gas well How many feet? 10'

| FROM | TO | PLUGGING MATERIALS | FROM | TO | PLUGGING MATERIALS |
|------|----|---------------------------------------|------|----|--------------------|
| | | <u>Funk Mt. Manway was removed</u> | | | |
| | | <u>2" PVC pipe was pulled to T.D.</u> | | | |
| | | <u>Bentonite from 35'-1'</u> | | | |
| | | <u>Asphalt 1'-0'</u> | | | |
| | | | | | |
| | | | | | |

7 CONTRACTOR'S OR LANDOWNER'S CERTIFICATION: This water well was plugged under my jurisdiction and was completed on (mo/day/year) 4/9/18 and this record is true to the best of my knowledge and belief. Kansas Water Well Contractor's License No. 432. This Water Well Record was completed on (mo/day/year) 4/21/18 under the business name of G.B. Environmental by (signature) James Bieker

INSTRUCTIONS: Use typewriter or ballpoint pen. Please press firmly and print clearly. Please fill in blanks, underline or circle the correct answers. Send top three copies to Kansas Department of Health and Environment, Bureau of Water, Geology Section, 1000 SW Jackson St., Ste. 420, Topeka, Kansas 66612-1367. Telephone: 785/296-5522. Send one to Water Well Owner and retain one for your records. Visit us at <http://www.kdheks.gov/geo/waterwells>.