


WATER WELL PLUGGING RECORD Form WWC-5P

KSA 82a-1212 ID NO. # 5

1 LOCATION OF WATER WELL: County: <u>Wyandotte</u>	Fraction <u>SE 1/4 SW 1/4 SE 1/4</u>	Section Number <u>15</u>	Township Number <u>11</u>	Range Number <u>25</u> EW
---	---	-----------------------------	------------------------------	--

Distance and direction from nearest town or city street address of well if located within city?
 owners James P. Barry; Kansas Ave Prop. LLC 3840 W. 139th. Terr
Leawood, KS, 66204
 info:

2 WATER WELL OWNER: <u>James P. Barry</u> RR#, St. Address, Box #: <u>51 Kansas Ave</u> City, State ZIP Code: <u>Kansas City, Ks.</u>	Global Positioning Systems (decimal degrees, min. of 4 digits) Latitude: <u>39 05 16.30</u> Longitude: <u>94 36 59.56</u> Elevation: _____ Datum: _____ Data Collection Method: <u>Google Earth</u>
---	--

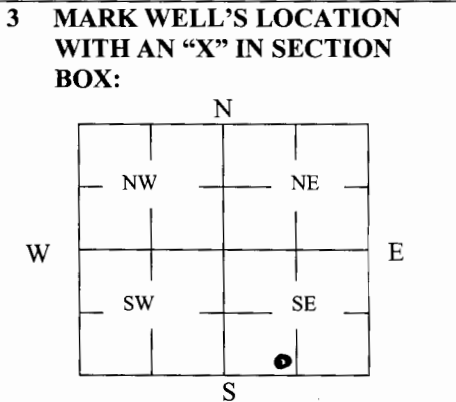

4 DEPTH OF WELL 35' ft.

WELL'S STATIC WATER LEVEL 26.78 ft.

WELL WAS USED AS:

1 Domestic	5 Public Water Supply	9 Dewatering
2 Irrigation	6 Oil Field Water Supply	<input checked="" type="radio"/> 10 Monitoring
3 Feedlot	7 Domestic (Lawn & Garden)	11 Injection Well
4 Industrial	8 Air Conditioning	12 Other _____

Was a chemical/bacteriological sample submitted to Department? Yes _____ No

5 TYPE OF BLANK CASING USED:

1 Steel	3 RMP (SR)	5 Wrought	7 Fiberglass	9 Other (Specify below)
<input checked="" type="radio"/> 2 PVC	4 ABS	6 Asbestos-Cement	8 Concrete Tile	_____

Blank casing diameter 2" in. Was casing pulled? Yes No _____ If yes, how much Total Depth
 Casing height above or below land surface N/A in.

6 GROUT PLUG MATERIAL: 1 Neat cement 2 Cement grout 3 Bentonite 4 Other Asphalt

Grout Plug Intervals: From 35' ft. to 1' ft., From _____ ft. to _____ ft., From 1' to 0' ft.

What is the nearest source of possible contamination: Former

1 Septic tank	6 Seepage pit	<input checked="" type="radio"/> 11 Fuel Storage	16 Other (specify below)
2 Sewer lines	7 Pit privy	12 Fertilizer storage	_____
3 Watertight sewer lines	8 Sewage lagoon	13 Insecticide storage	_____
4 Lateral lines	9 Feedyard	14 Abandoned water well	Direction from well? <u>Southwest</u>
5 Cess pool	10 Livestock pens	15 Oil well/Gas well	How many feet? <u>60'</u>

FROM	TO	PLUGGING MATERIALS	FROM	TO	PLUGGING MATERIALS
		<u>Flush Mt. Hardware was removed</u>			
		<u>2" PVC pipe was pulled out to T.D.</u>			
		<u>Bentonite 35'-1'</u>			
		<u>Asphalt 1'-0'</u>			

7 CONTRACTOR'S OR LANDOWNER'S CERTIFICATION: This water well was plugged under my jurisdiction and was completed on (mo/day/year) 4/9/18 and this record is true to the best of my knowledge and belief. Kansas Water Well Contractor's License No. 732. This Water Well Record was completed on (mo/day/year) 4/24/18 under the business name of QB Environmental by (signature) James Barber

INSTRUCTIONS: Use typewriter or ballpoint pen. Please press firmly and print clearly. Please fill in blanks, underline or circle the correct answers. Send top three copies to Kansas Department of Health and Environment, Bureau of Water, Geology Section, 1000 SW Jackson St., Ste. 420, Topeka, Kansas 66612-1367. Telephone: 785/296-5522. Send one to Water Well Owner and retain one for your records. Visit us at <http://www.kdheks.gov/geo/waterwells>.