

MW 1

KSA 82a-1212


Wyandotte

SE SE NE SE

24-11-25

PROJECT: Xpress Mart		PROJECT NUMBER: U4-105-14845		CLIENT: FM Associates, LLC		BORING NO.: MW1	
STREET ADDRESS: 1800 Steele Rd. CITY, STATE: Kansas City, KS				DRILLING CONTRACTOR: Razek		DRILL RIG TYPE: DPT/HSA	
GEOLOGIST: Ryan Weiser		DATE	STARTED: 8/28/18		BORING DIAMETER: 2.25/8.25		TOP OF CASING ELEVATION: 969.26
DRILL CREW: Greg Goode, Tony Poulter			COMPLETED: 8/28/18		TOTAL DEPTH: 19		GROUNDWATER DEPTH:
			PAD ELEVATION: 969.82			SWL ELEVATION:	


DEPTH (ft)	Soil Group Name: modifier, color, moisture, density/consistency, grain size, other descriptors Rock Description: modifier color, hardness/degree of concentration, bedding and joint characteristics, solutions, void conditions.	PID (ppm)	LAB SAMPLES	BORING COMPLETION
0.5	Topsoil. Brown, silty, sandy; slight-non plastic; no odor			
0.7				
1				
1.3	SILT. Brown, sandy, dry slight-non plastic; no odor			
2				
7				
9	SHALE. Silty, sandy, brown, dry, weathered, fissile, no odor			
18				
30	SHALE. Silty, sandy, purple, dry, weathered, fissile, no odor			
40				
Total Depth = 19' Casing Diameter=2" Soil samples collected continuously with dual tube sampler. ABBREVIATIONS: HSA - Hollow-stem auger DPT - Direct-push technology UNK - Unknown NR - No Recovery PID - Photionization detector				

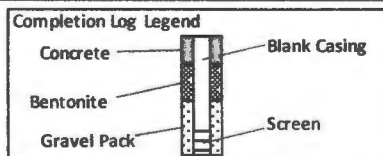

Wyandotte

SE NE SE

29-115-25E

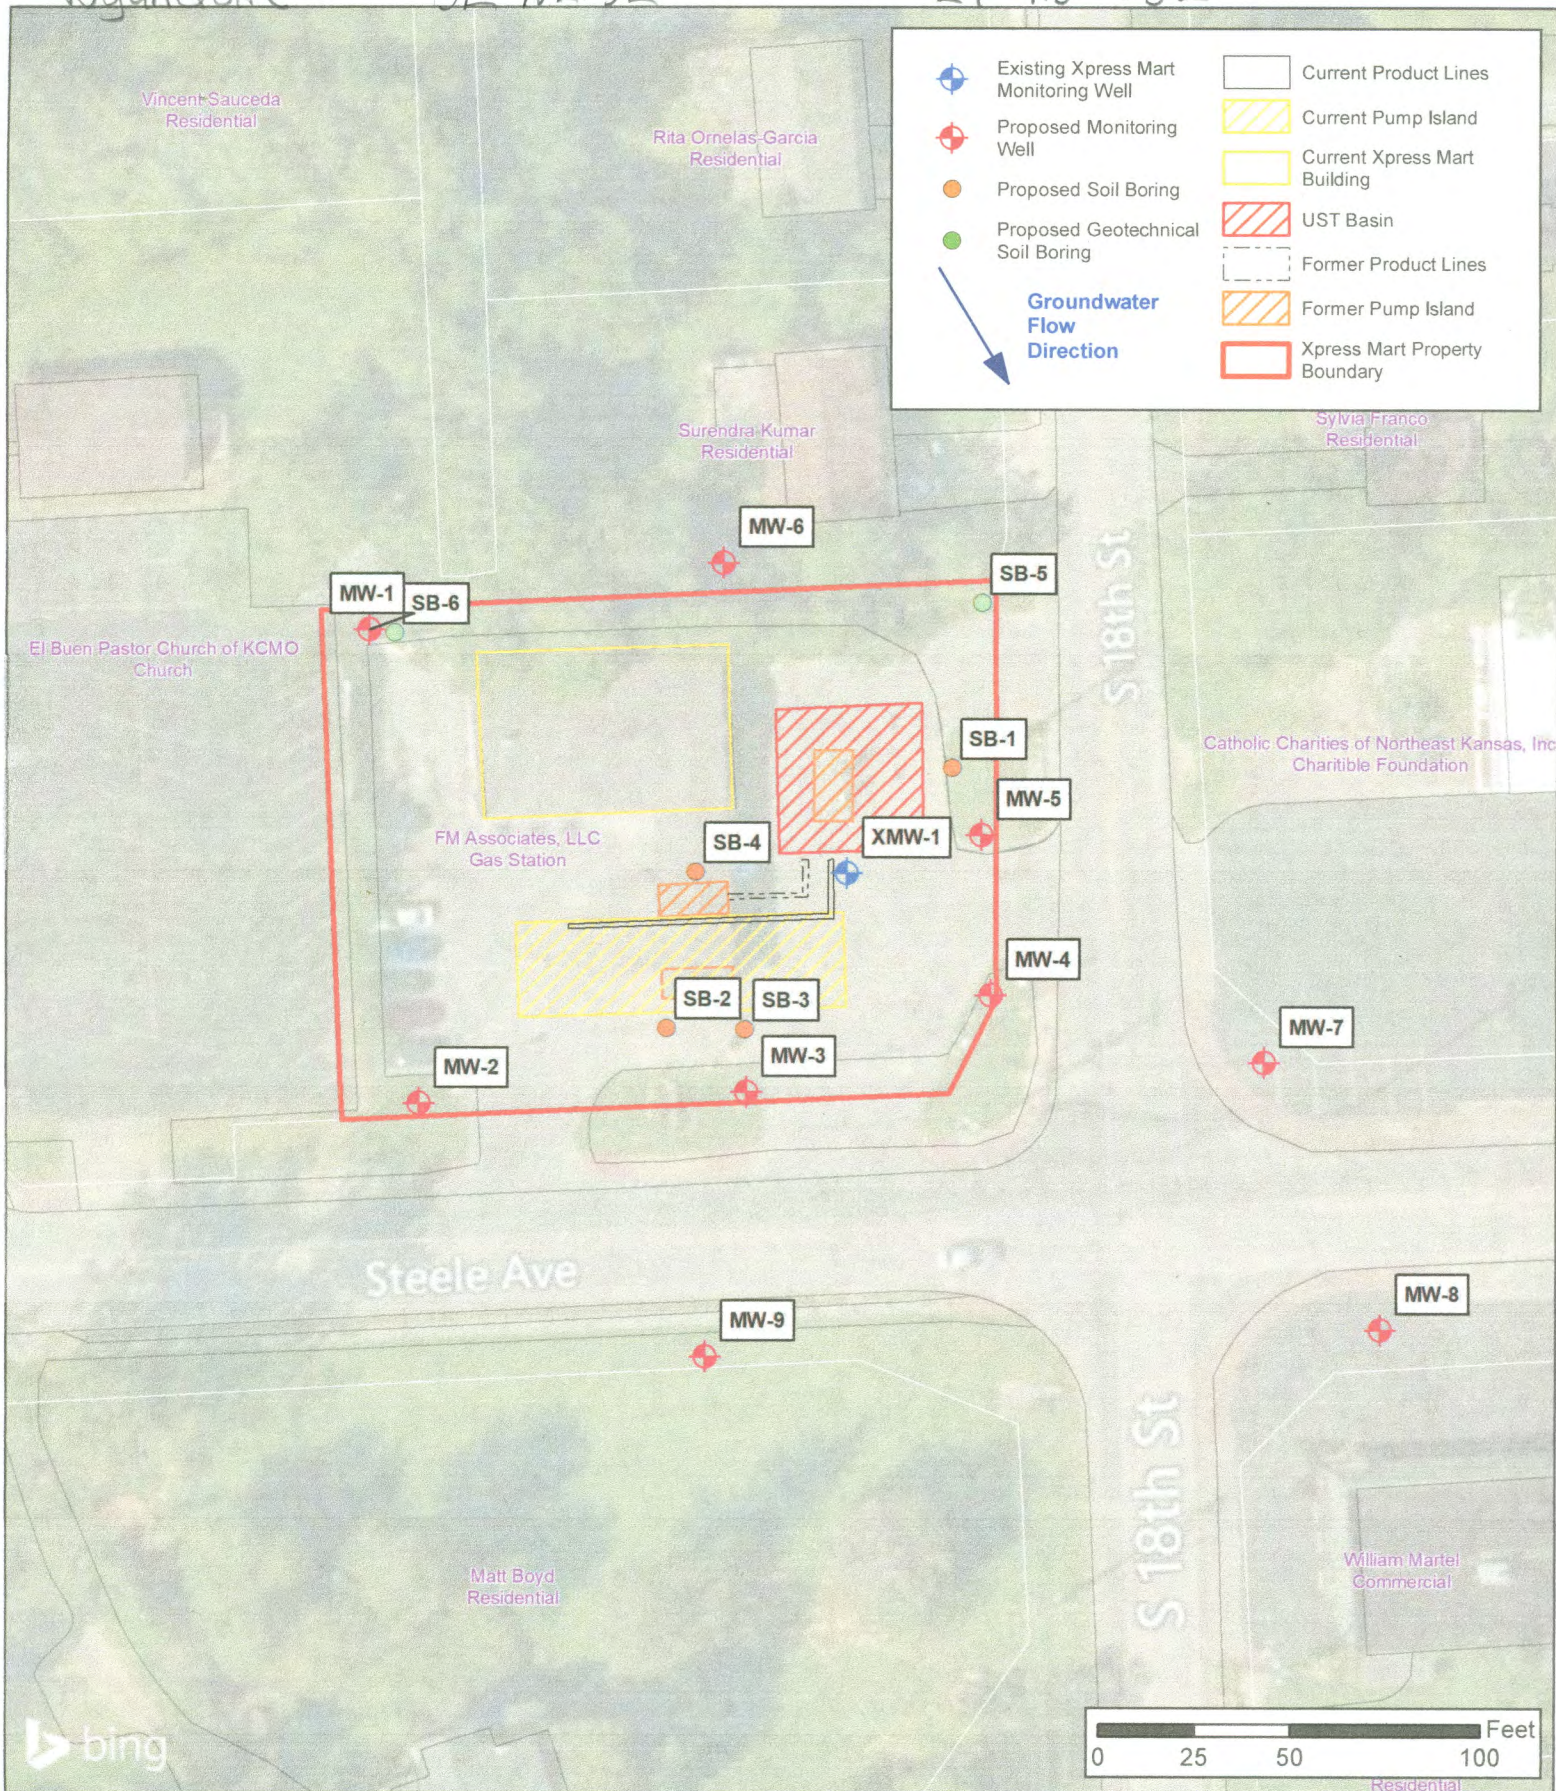

DESIGNED BY: CC		Detailed Site Map Xpress Mart		FIGURE 2	LSA Work Plan		
DRAWN BY: CC							
CHECKED BY: RW			U4-105-14845 1800 Steele Road Kansas City, KS				
APPROVED BY: CC							
DATE: JUNE 2018							