

MW 3

KSA 82a-1212

Wyandotte

SE NE SE


29-11-25

PROJECT: Xpress Mart		PROJECT NUMBER: U4-105-14845		CLIENT: FM Associates, LLC		BORING NO.: MW3			
STREET ADDRESS: 1800 Steele Rd. CITY, STATE: Kansas City, KS				DRILLING CONTRACTOR: Razek		DRILL RIG TYPE: DPT/HSA			
GEOLOGIST: Ryan Weiser		DATE	STARTED: 8/27/18		BORING DIAMETER: 2.25/8.25		TOP OF CASING ELEVATION: 952.72		
DRILL CREW: Greg Goode, Tony Poulter			COMPLETED: 8/27/18		TOTAL DEPTH: 11.5		GROUNDWATER DEPTH: Dry		
				PAD ELEVATION: 953.08		SWL ELEVATION:			
DEPTH (ft)	Soil Group Name: modifier, color, moisture, density/consistency, grain size, other descriptors						PID (ppm)	LAB SAMPLES	BORING COMPLETION
	Rock Description: modifier, color, hardness/degree of concentration, bedding and joint characteristics, solutions, void conditions.								
10	Topsoil, brown, silty, sandy; dry; no odor						12.5		
	SILT. Tan-orange-brown, sandy, clayey, slightly plastic, no odor						2.3		
							1.6		
	SAND. Brown-grey, fine grained; non plastic, dry, no odor						1.3		
	SHALE. Weathered, sandy, tan, dry, flaky, no odor						1.5		
20	Weathered Limestone						1.3		
30	Total Depth = 11.5'								
	Casing Diameter=2"								
Soil samples collected continuously with dual tube sampler.									
ABBREVIATIONS: UNK - Unknown HSA - Hollow-stem auger DPT - Direct-push technology NR - No Recovery PID - Photionization detector									

Wyandotte

SE NE SE

29-115-25E

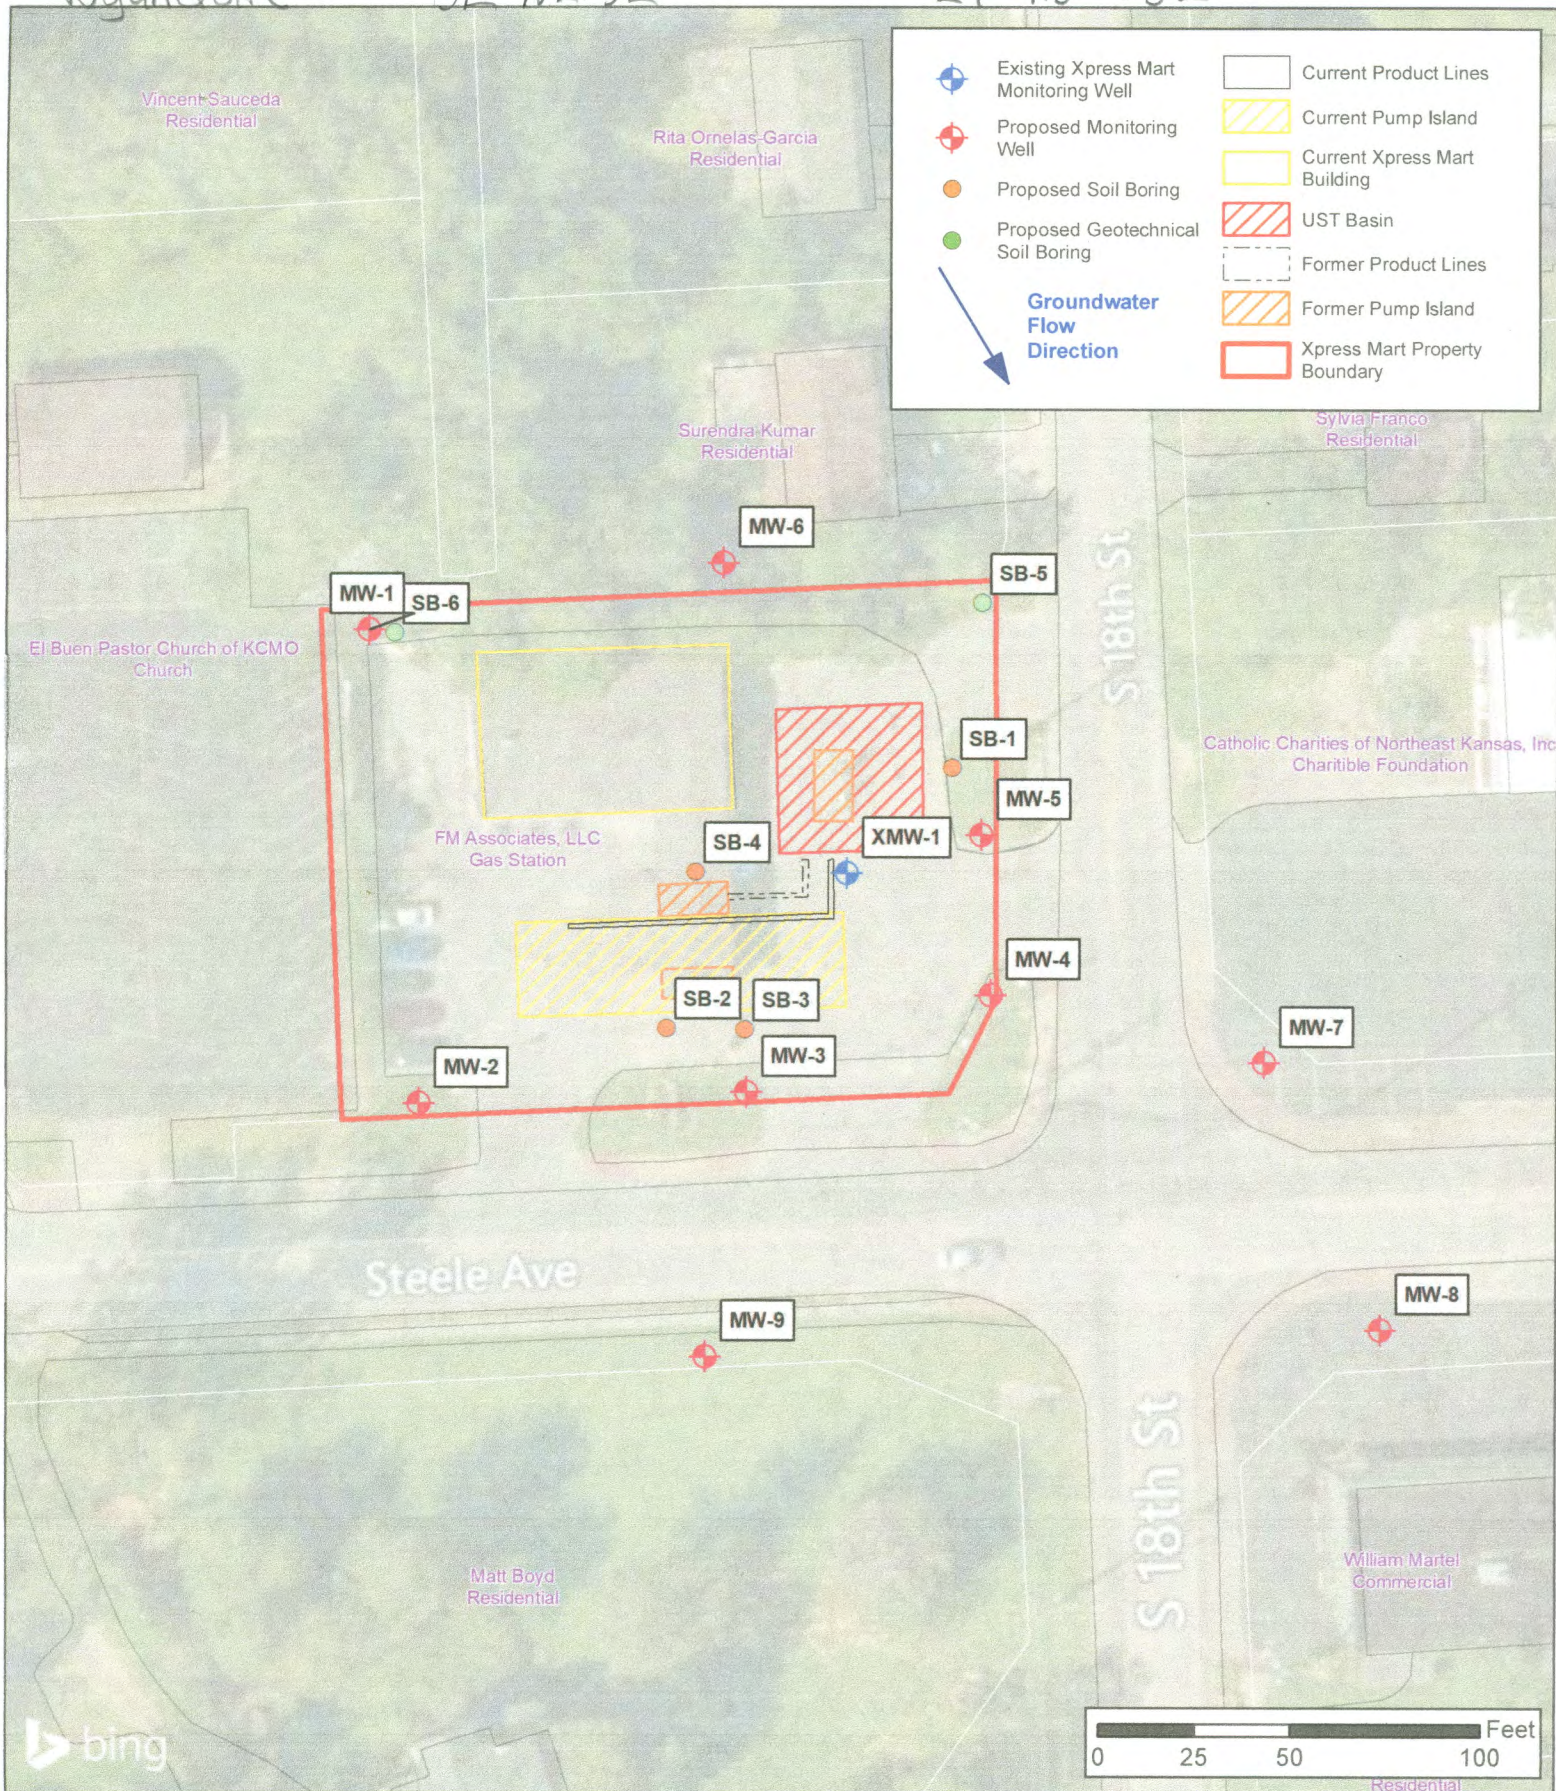

DESIGNED BY: CC		<div>Detailed Site Map Xpress Mart</div>		FIGURE 2	LSA Work Plan
DRAWN BY: CC					
CHECKED BY: RW		<div> U4-105-14845 1800 Steele Road Kansas City, KS</div>			
APPROVED BY: CC					
DATE: JUNE 2018			<div>professional practical below-ground</div>		