


MW 4

KSA 82a-1212

Wyandotte

SE NE SE

29-11-25


PROJECT: Xpress Mart		PROJECT NUMBER: U4-105-14845		CLIENT: FM Associates, LLC		BORING NO.: MW4		
STREET ADDRESS: 1800 Steele Rd. CITY, STATE: Kansas City, KS				DRILLING CONTRACTOR: Razek		DRILL RIG TYPE: DPT/HSA		
GEOLOGIST: Ryan Weiser		DATE	STARTED: 8/27/18		BORING DIAMETER: 2.25/8.25		TOP OF CASING ELEVATION: 950.59	
DRILL CREW: Greg Goode, Tony Poulter			COMPLETED: 8/27/18		TOTAL DEPTH: 11		GROUNDWATER DEPTH: 9.15	
				PAD ELEVATION: 950.9		SWL ELEVATION: 941.44		
DEPTH (ft)	Soil Group Name: modifier, color, moisture, density/consistency, grain size, other descriptors					PID (ppm)	LAB SAMPLES	BORING COMPLETION
	Rock Description: modifier color, hardness/degree of concentration, bedding and joint characteristics, solutions, void conditions.							
10					Topsoil, brown, silty, sandy; dry; no odor	76.2		
					SILT. Tan-brown, slightly plastic, slightly moist	49.4		
						80		
					SILT. Green-grey; plastic, slight odor	82.2		
					SHALE. Weathered, sandy, tan, dry, flaky, no odor	187.5		
					Weathered Urnstone	32.6		
20	Total Depth = 11' Casing Diameter = 2"							
	Soil samples collected continuously with dual tube sampler.							
30								

ABBREVIATIONS:
 UNK - Unknown
 HSA - Hollow-stem auger
 DPT - Direct-push technology
 NR - No Recovery
 PID - Photionization detector

Wyandotte

SE NE SE

29-115-25E

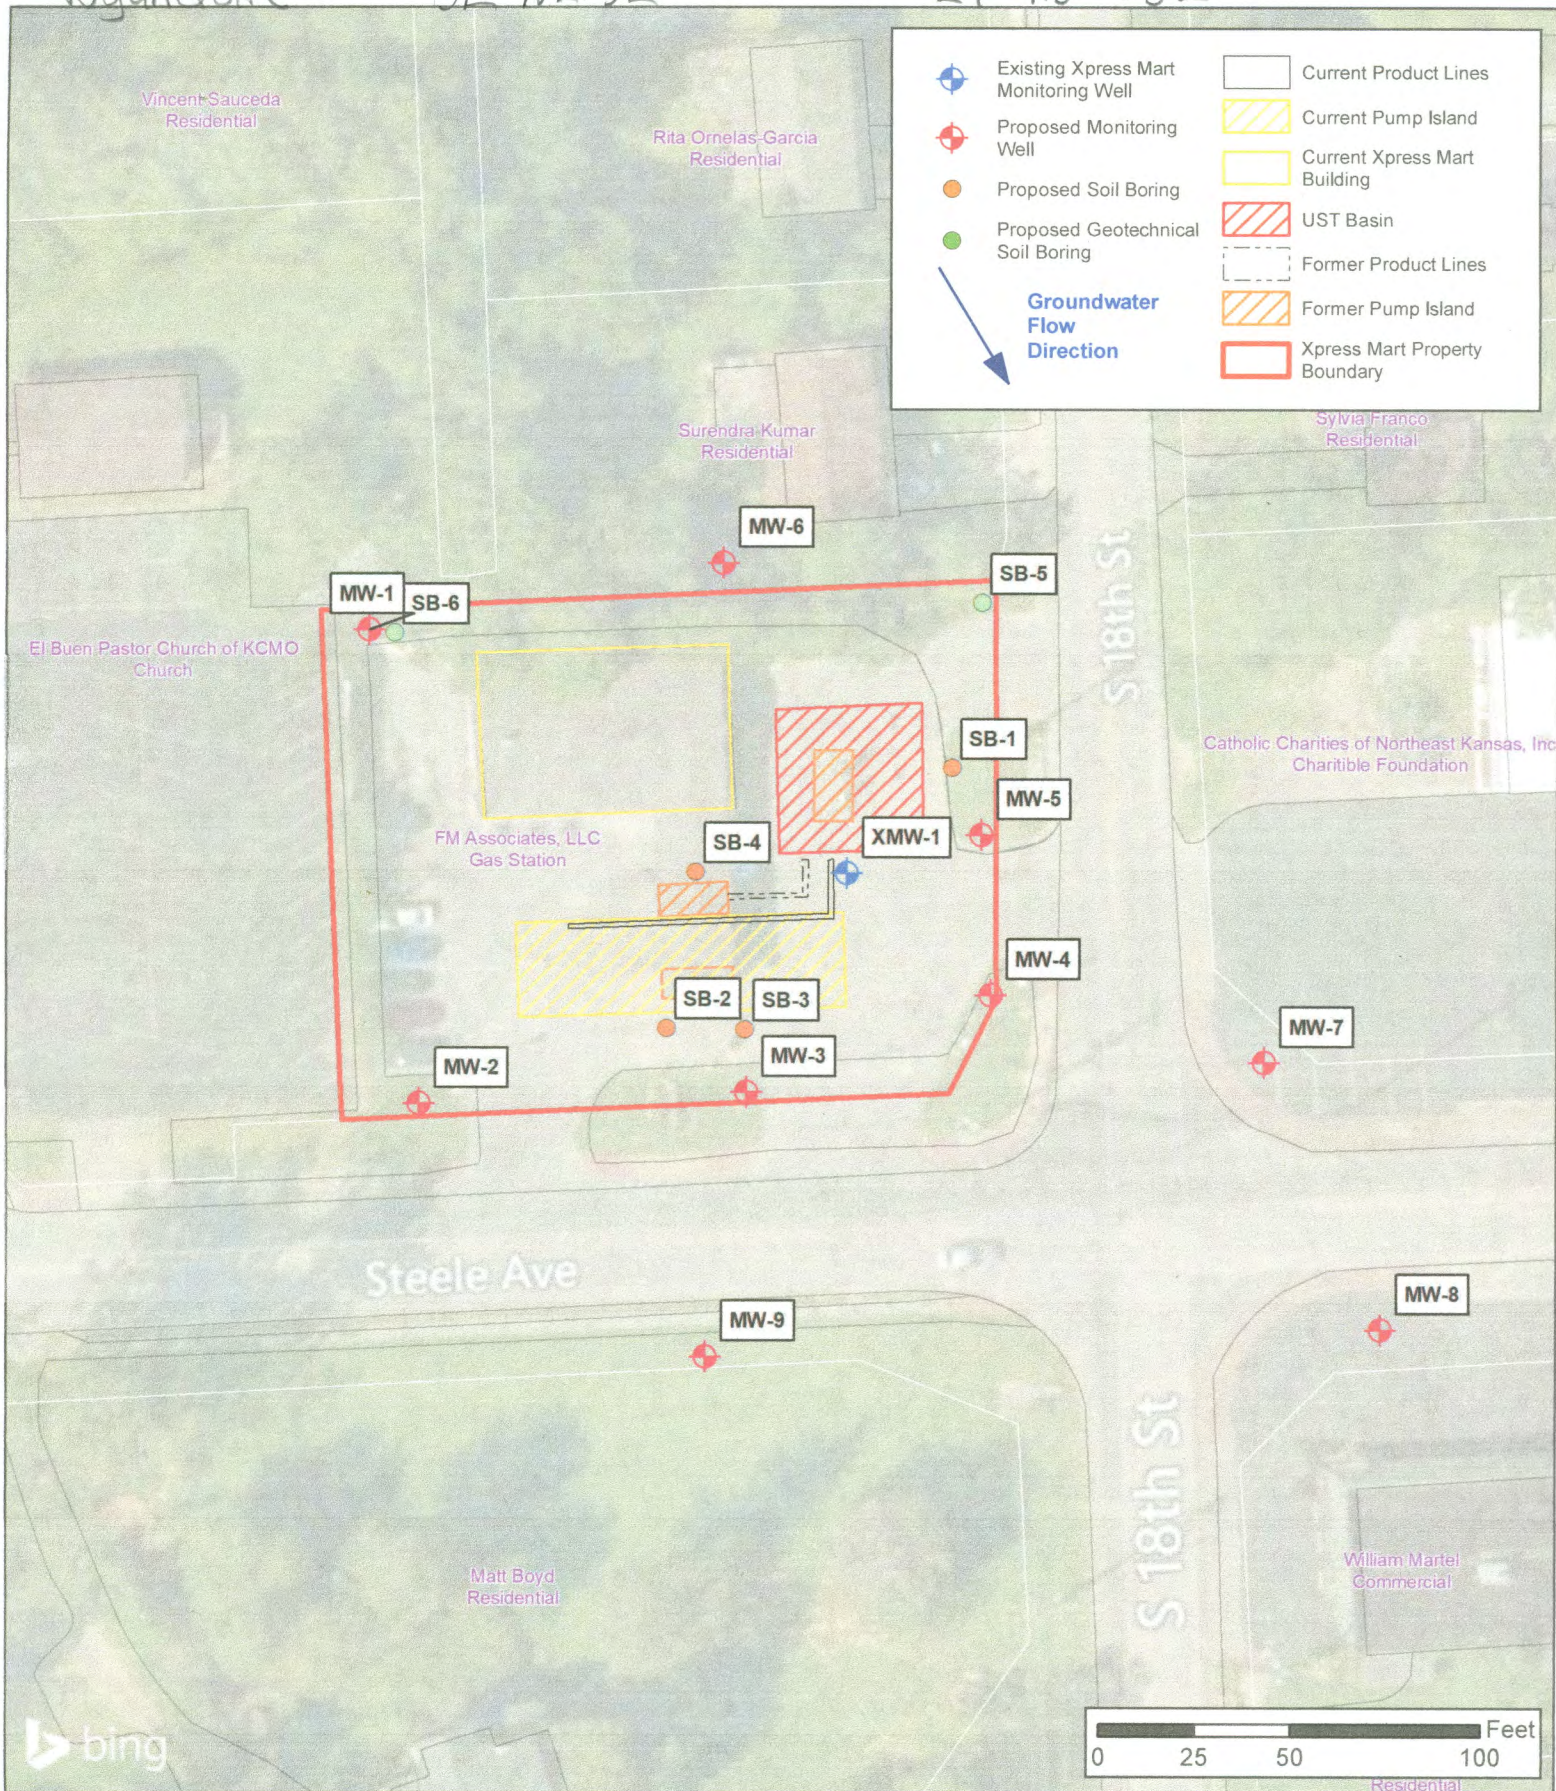

DESIGNED BY: CC		<div>Detailed Site Map Xpress Mart</div>		FIGURE 2	LSA Work Plan		
DRAWN BY: CC							
CHECKED BY: RW			U4-105-14845 1800 Steele Road Kansas City, KS				
APPROVED BY: CC							
DATE: JUNE 2018							