

MW 5

KSA 82a-1212

Wyanadotte

JE NE CT


29-11-25

PROJECT: Xpress Mart		PROJECT NUMBER: U4-105-14845		CLIENT: FM Associates, LLC		BORING NO.: MW5	
STREET ADDRESS: 1800 Steele Rd.				DRILLING CONTRACTOR: Razeq		DRILL RIG TYPE: DPT/HSA	
CITY, STATE: Kansas City, KS				BORING DIAMETER: 2.25/8.25		TOP OF CASING ELEVATION: 952.40	
GEOLOGIST: Ryan Weiser		DATE	STARTED: 8/27/18	TOTAL DEPTH: 11		GROUNDWATER DEPTH: 5.45	
DRILL CREW: Greg Goode, Tony Poulter			COMPLETED: 8/27/18				
			PAD ELEVATION: 952.68		SWL ELEVATION: 946.95		
DEPTH (ft)	Soil Group Name: modifier, color, moisture, density/consistency, grain size, other descriptors				PID (ppm)	LAB SAMPLES	BORING COMPLETION
	Rock Description: modifier color, hardness/degree of concentration, bedding and joint characteristics, solutions, void conditions.						
10	Topsoil, brown, silty, sandy; no odor				2.1	X	
	Limestone, fractured, grey				4.2	X	
	SILT. Sandy, slight plastic, sandy, clayey, LS intermixed @4' with orange mottling; dry; no recovery from 5'-8.5'				1.6		
	CLAY. Moist, orange brown with grey and orange-green mottling, plastic; silty; slight odor.				NR 63.9	X	
20	Total Depth = 11' Casing Diameter=2"						
30	Soil samples collected continuously with dual tube sampler.						
ABBREVIATIONS: HSA - Hollow-stem auger DPT - Direct-push technology UNK - Unknown NR - No Recovery PID - Photionization detector							

Wyandotte

SE NE SE

29-115-25E

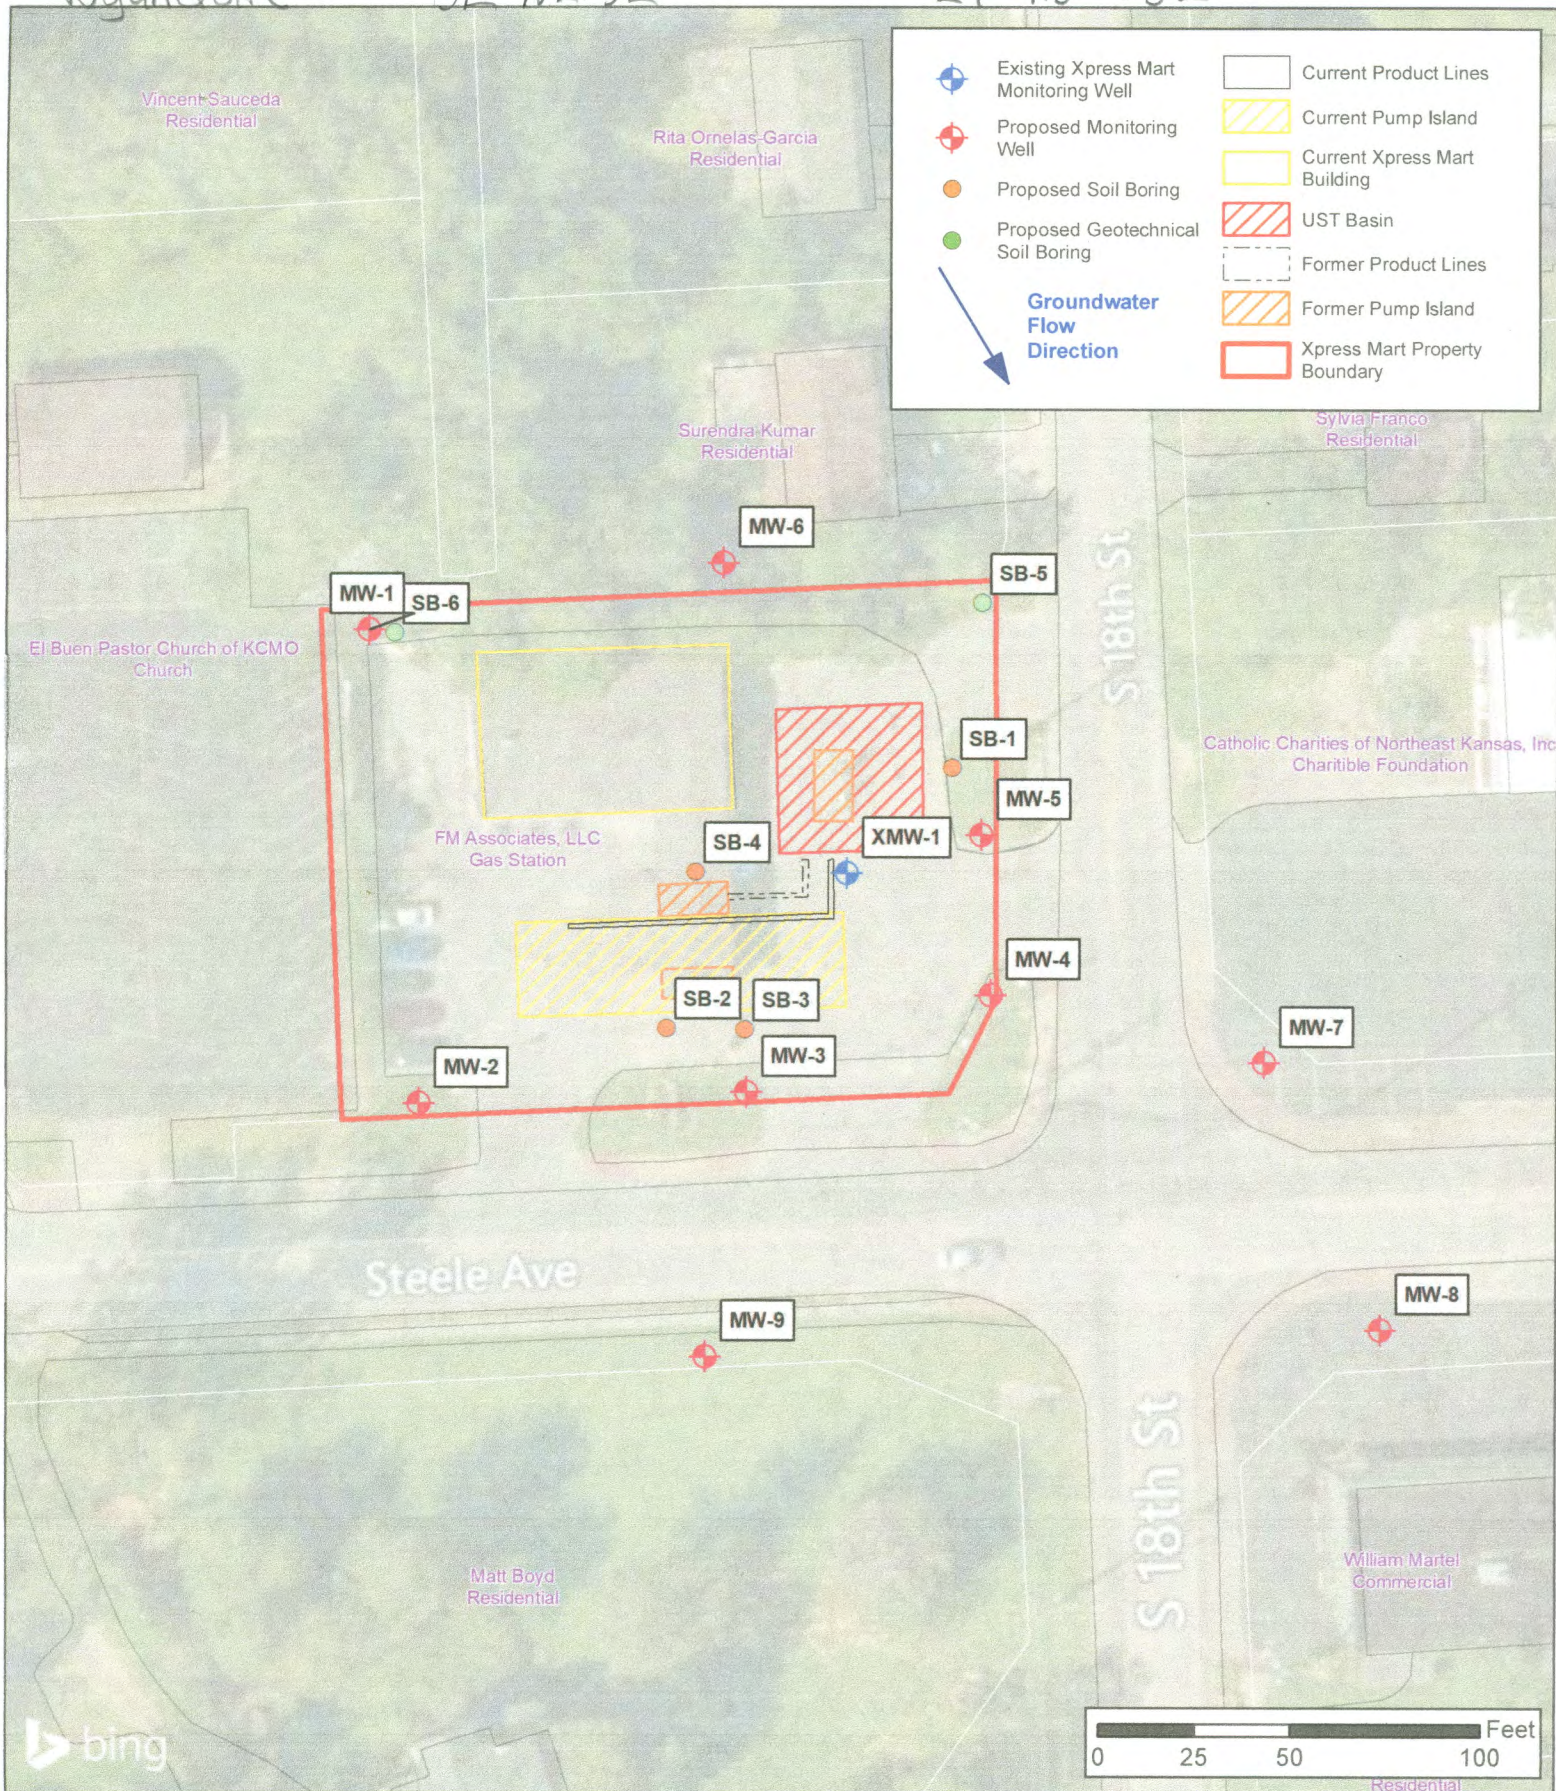

DESIGNED BY: CC		<div>Detailed Site Map Xpress Mart</div>		FIGURE 2	LSA Work Plan		
DRAWN BY: CC							
CHECKED BY: RW			U4-105-14845 1800 Steele Road Kansas City, KS				
APPROVED BY: CC							
DATE: JUNE 2018							