

## WATER WELL RECORD

## Form WWC-5

Division of Water Resources App. No.

MW 7

<b>1 LOCATION OF WATER WELL:</b> County: Wyandotte		Fraction ¼ SW ¼ NW ¼ SW ¼		Section Number 28		Township No. T 11 S		Range Number R 25 <input checked="" type="checkbox"/> E <input type="checkbox"/> W	
Street/Rural Address of Well Location; if unknown, distance & direction from nearest town or intersection: If at owner's address, check here <input type="checkbox"/> Xpress Mart #6 1800 Steele Road, Kansas City, KS				<b>Global Positioning System (GPS) information:</b> Latitude: 39.06241 (in decimal degrees) Longitude: 94.64896 (in decimal degrees) Elevation: 947.78 Datum: <input checked="" type="checkbox"/> WGS 84, <input type="checkbox"/> NAD 83, <input type="checkbox"/> NAD 27 Collection Method: <input type="checkbox"/> GPS unit (Make/Model: _____) <input type="checkbox"/> Digital Map/Photo, <input type="checkbox"/> Topographic Map, <input checked="" type="checkbox"/> Land Survey Est. Accuracy: <input checked="" type="checkbox"/> <3 m, <input type="checkbox"/> 3-5 m, <input type="checkbox"/> 5-15 m, <input type="checkbox"/> >15 m	
<b>2 WATER WELL OWNER:</b> FM Associates, LLC RR#, Street Address, Box #: 18023 Melrose Drive City, State, ZIP Code : Bucyrus, KS 66013	
<b>3 LOCATE WELL WITH AN "X" IN SECTION BOX:</b> N <table border="1" style="width:100%; text-align: center;"> <tr><td></td><td></td><td></td></tr> <tr><td>-- NW --</td><td></td><td>-- NE --</td></tr> <tr><td>W</td><td></td><td>E</td></tr> <tr><td>-- SW --</td><td></td><td>-- SE --</td></tr> <tr><td></td><td></td><td></td></tr> <tr><td>S</td><td></td><td></td></tr> </table> S  -----1 mile-----					-- NW --		-- NE --	W		E	-- SW --		-- SE --				S			<b>4 DEPTH OF COMPLETED WELL 8.0</b> ft. Depth(s) Groundwater Encountered (1) Dry (2) N/A (3) N/A WELL'S STATIC WATER LEVEL Dry ft. below land surface measured on mo/day/yr. 9-8-18 Pump test data: Well water was N/A ft. after N/A hours pumping N/A gpm EST. YIELD N/A gpm. Well water was N/A ft. after N/A hours pumping N/A gpm Bore Hole Diameter 8.25 in. to 8.0 ft., and N/A in. to N/A ft. WELL WATER TO BE USED AS: <input type="checkbox"/> Public water supply <input type="checkbox"/> Geothermal <input type="checkbox"/> Injection well <input type="checkbox"/> Domestic <input type="checkbox"/> Feedlot <input type="checkbox"/> Oil field water supply <input type="checkbox"/> Dewatering <input type="checkbox"/> Other (Specify below) <input type="checkbox"/> Irrigation <input type="checkbox"/> Industrial <input type="checkbox"/> Domestic-lawn & garden <input checked="" type="checkbox"/> Monitoring well MW-7 Was a chemical/bacteriological sample submitted to Department? <input type="checkbox"/> Yes <input checked="" type="checkbox"/> No If yes, mo/day/yr sample was submitted N/A Water well disinfected? <input type="checkbox"/> Yes <input checked="" type="checkbox"/> No	
-- NW --		-- NE --	
W		E	
-- SW --		-- SE --	
S	
<b>5 TYPE OF CASING USED:</b> <input type="checkbox"/> Steel <input checked="" type="checkbox"/> PVC <input type="checkbox"/> Other _____ CASING JOINTS: <input type="checkbox"/> Glued <input type="checkbox"/> Clamped <input type="checkbox"/> Welded <input checked="" type="checkbox"/> Threaded Casing diameter 2 in. to 5.0 ft., Diameter N/A in. to N/A ft., Diameter N/A in. to N/A ft. Casing height above land surface 0 in., Weight N/A lbs./ft., Wall thickness or gauge No. Sch. 40 <b>TYPE OF SCREEN OR PERFORATION MATERIAL:</b> <input type="checkbox"/> Steel <input type="checkbox"/> Stainless Steel <input checked="" type="checkbox"/> PVC <input type="checkbox"/> Other (Specify) _____ <input type="checkbox"/> Brass <input type="checkbox"/> Galvanized Steel <input type="checkbox"/> None used (open hole) <b>SCREEN OR PERFORATION OPENINGS ARE:</b> <input type="checkbox"/> Continuous slot <input checked="" type="checkbox"/> Mill slot <input type="checkbox"/> Gauze wrapped <input type="checkbox"/> Torch cut <input type="checkbox"/> Drilled holes <input type="checkbox"/> None (open hole) <input type="checkbox"/> Louvered shutter <input type="checkbox"/> Key punched <input type="checkbox"/> Wire wrapped <input type="checkbox"/> Saw cut <input type="checkbox"/> Other (specify) _____ <b>SCREEN-PERFORATED INTERVALS:</b> From 5.0 ft. to 8.0 ft., From N/A ft. to N/A ft. From N/A ft. to N/A ft., From N/A ft. to N/A ft. <b>GRAVEL PACK INTERVALS:</b> From 3.0 ft. to 8.0 ft., From N/A ft. to N/A ft. From N/A ft. to N/A ft., From N/A ft. to N/A ft.	
<b>6 GROUT MATERIAL:</b> <input type="checkbox"/> Neat cement <input type="checkbox"/> Cement grout <input checked="" type="checkbox"/> Bentonite <input checked="" type="checkbox"/> Other Concrete 0 to 1-feet Grout Intervals: From 1.0 ft. to 3.0 ft., From N/A ft. to N/A ft., From N/A ft. to N/A ft. What is the nearest source of possible contamination: <input type="checkbox"/> Septic tank <input type="checkbox"/> Lateral lines <input type="checkbox"/> Pit privy <input type="checkbox"/> Livestock pens <input type="checkbox"/> Insecticide storage <input type="checkbox"/> Other (specify below) <input type="checkbox"/> Sewer lines <input type="checkbox"/> Cesspool <input type="checkbox"/> Sewage lagoon <input checked="" type="checkbox"/> Fuel storage <input type="checkbox"/> Abandoned water well <input type="checkbox"/> Watertight sewer lines <input type="checkbox"/> Seepage pit <input type="checkbox"/> Feedyard <input type="checkbox"/> Fertilizer storage <input type="checkbox"/> Oil well/gas well Direction from well Northwest Distance from well 100-feet	
<table border="1" style="width:100%; border-collapse: collapse;"> <thead> <tr> <th style="width:10%;">FROM</th> <th style="width:10%;">TO</th> <th style="width:40%;">LITHOLOGIC LOG</th> <th style="width:10%;">FROM</th> <th style="width:10%;">TO</th> <th style="width:20%;">LITHO. LOG (cont.) or PLUGGING INTERVALS</th> </tr> </thead> <tbody> <tr> <td></td> <td></td> <td>Attached</td> <td></td> <td></td> <td></td> </tr> <tr><td> </td><td> </td><td> </td><td> </td><td> </td><td> </td></tr> <tr><td> </td><td> </td><td> </td><td> </td><td> </td><td> </td></tr> <tr><td> </td><td> </td><td> </td><td> </td><td> </td><td> </td></tr> <tr><td> </td><td> </td><td> </td><td> </td><td> </td><td> </td></tr> <tr><td> </td><td> </td><td> </td><td> </td><td> </td><td> </td></tr> <tr><td> </td><td> </td><td> </td><td> </td><td> </td><td> </td></tr> <tr><td> </td><td> </td><td> </td><td> </td><td> </td><td> </td></tr> <tr><td> </td><td> </td><td> </td><td> </td><td> </td><td> </td></tr> <tr><td> </td><td> </td><td> </td><td> </td><td> </td><td> </td></tr> </tbody> </table>										FROM	TO	LITHOLOGIC LOG	FROM	TO	LITHO. LOG (cont.) or PLUGGING INTERVALS			Attached	
FROM	TO	LITHOLOGIC LOG	FROM	TO	LITHO. LOG (cont.) or PLUGGING INTERVALS	
		Attached	
<b>7 CONTRACTOR'S OR LANDOWNER'S CERTIFICATION:</b> This water well was <input checked="" type="checkbox"/> constructed, <input type="checkbox"/> reconstructed, or <input type="checkbox"/> plugged under my jurisdiction and was completed on (mo/day/year) 8/28/2018 and this record is true to the best of my knowledge and belief. Kansas Water Well Contractor's License No. 759 This Water Well Record was completed on (mo/day/year) 9/15/2018 under the business name of RAZEK Environmental, LLC by (signature) <i>Quincy Paul</i>	
<b>INSTRUCTIONS:</b> Use typewriter or ball point pen. PLEASE PRESS FIRMLY and PRINT clearly. Please fill in blanks and check the correct answers. Send one copy to Kansas Department of Health and Environment, Bureau of Water, Geology Section, 1000 SW Jackson St., Suite 420, Topeka, Kansas 66612-1367. Telephone 785-296-5524. Send one copy to WATER WELL OWNER and retain one for your records. Include fee of \$5.00 for each constructed well. Visit us at <a href="http://www.kdheks.gov/waterwell/index.html">http://www.kdheks.gov/waterwell/index.html</a>	

Wyandotte

SW NW SW

28-11-25


PROJECT: Xpress Mart		PROJECT NUMBER: U4-105-14845		CLIENT: FM Associates, LLC		BORING NO.: MW7			
STREET ADDRESS: 1800 Steele Rd. CITY, STATE: Kansas City, KS				DRILLING CONTRACTOR: Razek		DRILL RIG TYPE: DPT/HSA			
GEOLOGIST: Ryan Weiser		DATE	STARTED: 8/28/18		BORING DIAMETER: 2.25/8.25		TOP OF CASING ELEVATION: 947.28		
DRILL CREW: Greg Goode, Tony Poulter			COMPLETED: 8/28/18		TOTAL DEPTH: 8		GROUNDWATER DEPTH: Dry		
				PAD ELEVATION: 947.78		SWL ELEVATION:			
DEPTH (ft)	Soil Group Name: modifier, color, moisture, density/consistency, grain size, other descriptors						PID (ppm)	LAB SAMPLES	BORING COMPLETION
	Rock Description: modifier color, hardness/degree of concentration, bedding and joint characteristics, solutions, void conditions.								
10				Silt. 0.5" Asphalt, Black-brown, dry, sandy, non plastic, slight old petroleum odor 1-3'		240			
				Clay. silty, brown plastic, saturated 6'-7"		2.1			
				Weathered Limestone		1			
20	<p>Total Depth = 8'</p> <p>Casing Diameter=2"</p> <p>Soil samples collected continuously with dual tube sampler.</p>								
30									
<p>ABBREVIATIONS:</p> <p>HSA - Hollow-stem auger</p> <p>DPT - Direct-push technology</p> <p>UNK - Unknown</p> <p>NR - No Recovery</p> <p>PID - Photionization detector</p>									



Wyandotte

SE NE SE

29-115-25E

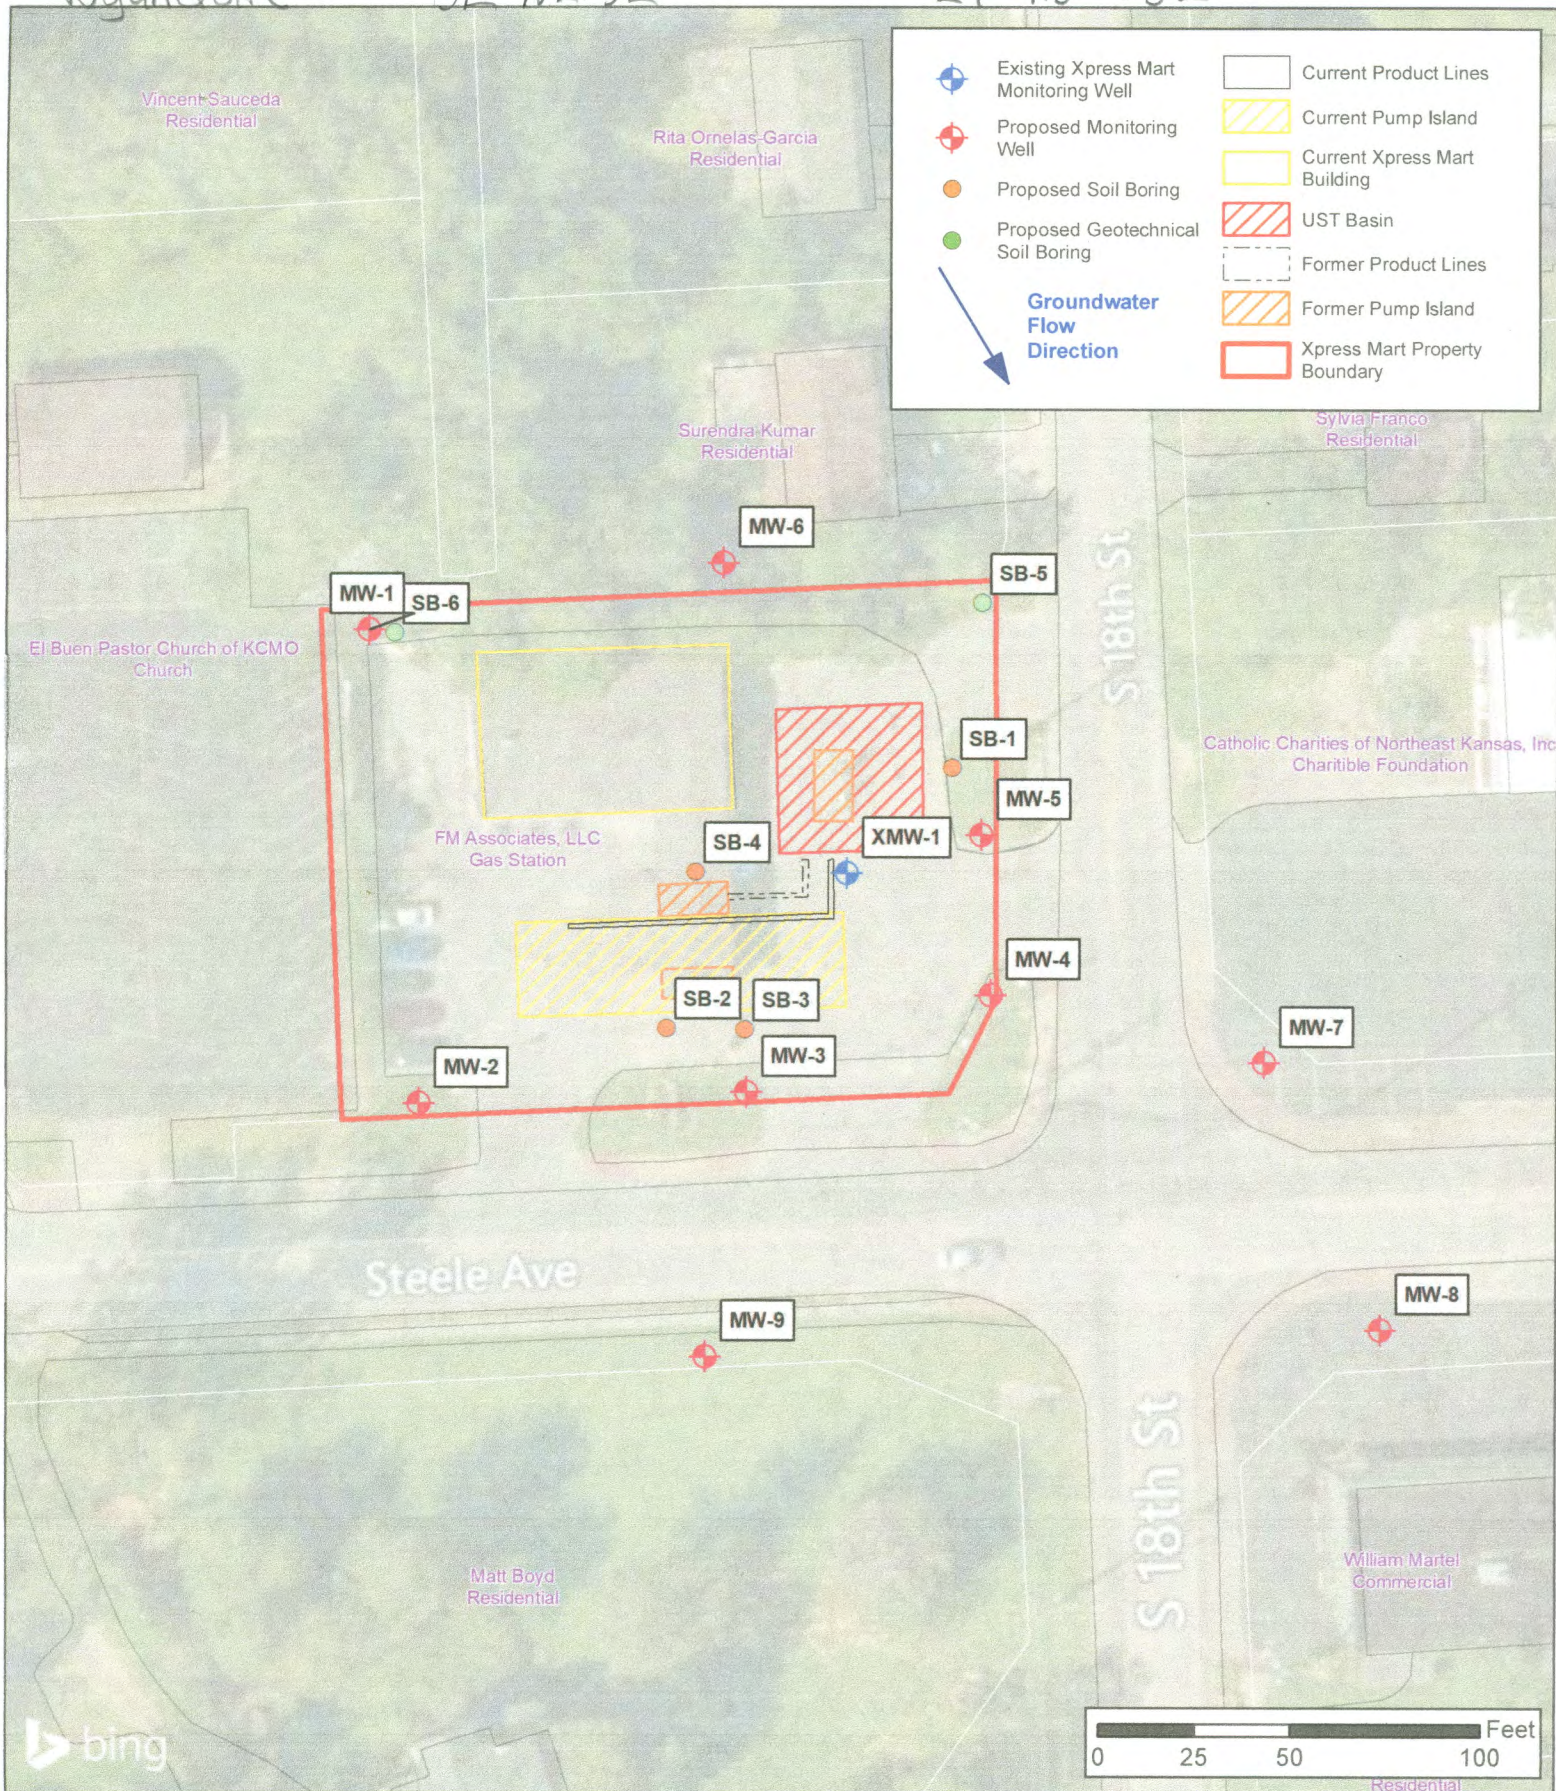

DESIGNED BY: CC		<div>Detailed Site Map Xpress Mart</div>		FIGURE  2	LSA Work Plan		
DRAWN BY: CC							
CHECKED BY: RW			U4-105-14845 1800 Steele Road Kansas City, KS				
APPROVED BY: CC							
DATE: JUNE 2018							