


MW 8

KSA 82a-1212

Wynandotte

NW SW SW


28-11-25

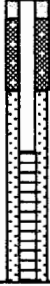PROJECT: Xpress Mart		PROJECT NUMBER: U4-105-14845		CLIENT: FM Associates, LLC		BORING NO.: MW8			
STREET ADDRESS: 1800 Steele Rd. CITY, STATE: Kansas City, KS				DRILLING CONTRACTOR: Razek		DRILL RIG TYPE: DPT/HSA			
GEOLOGIST: Ryan Weiser		DATE	STARTED: 8/28/18		BORING DIAMETER: 2.25/8.25		TOP OF CASING ELEVATION: 947.06		
DRILL CREW: Greg Goode, Tony Poulter			COMPLETED: 8/28/18		TOTAL DEPTH: 8		GROUNDWATER DEPTH: Dry		
			PAD ELEVATION: 947.29			SWL ELEVATION:			
DEPTH (ft)	Soil Group Name: modifier, color, moisture, density/consistency, grain size, other descriptors						PID (ppm)	LAB SAMPLES	BORING COMPLETION
	Rock Description: modifier color, hardness/degree of concentration, bedding and joint characteristics, solutions, void conditions.								
10				Fill, limestone, silt; slight old petroleum odor, grey, limy, dry			114		
				Silt: 0.5" Asphalt, Black-brown, dry, sandy, non plastic, slight old petroleum odor 1-3'			NR		
							2.7		
				Weathered Limestone			3.4		
20	Total Depth = 9' Casing Diameter=2"								
30	Soil samples collected continuously with dual tube sampler.								
ABBREVIATIONS: HSA - Hollow-stem auger DPT - Direct-push technology UNK - Unknown NR - No Recovery PID - Photionization detector									

Wyandotte

SE NE SE

29-115-25E

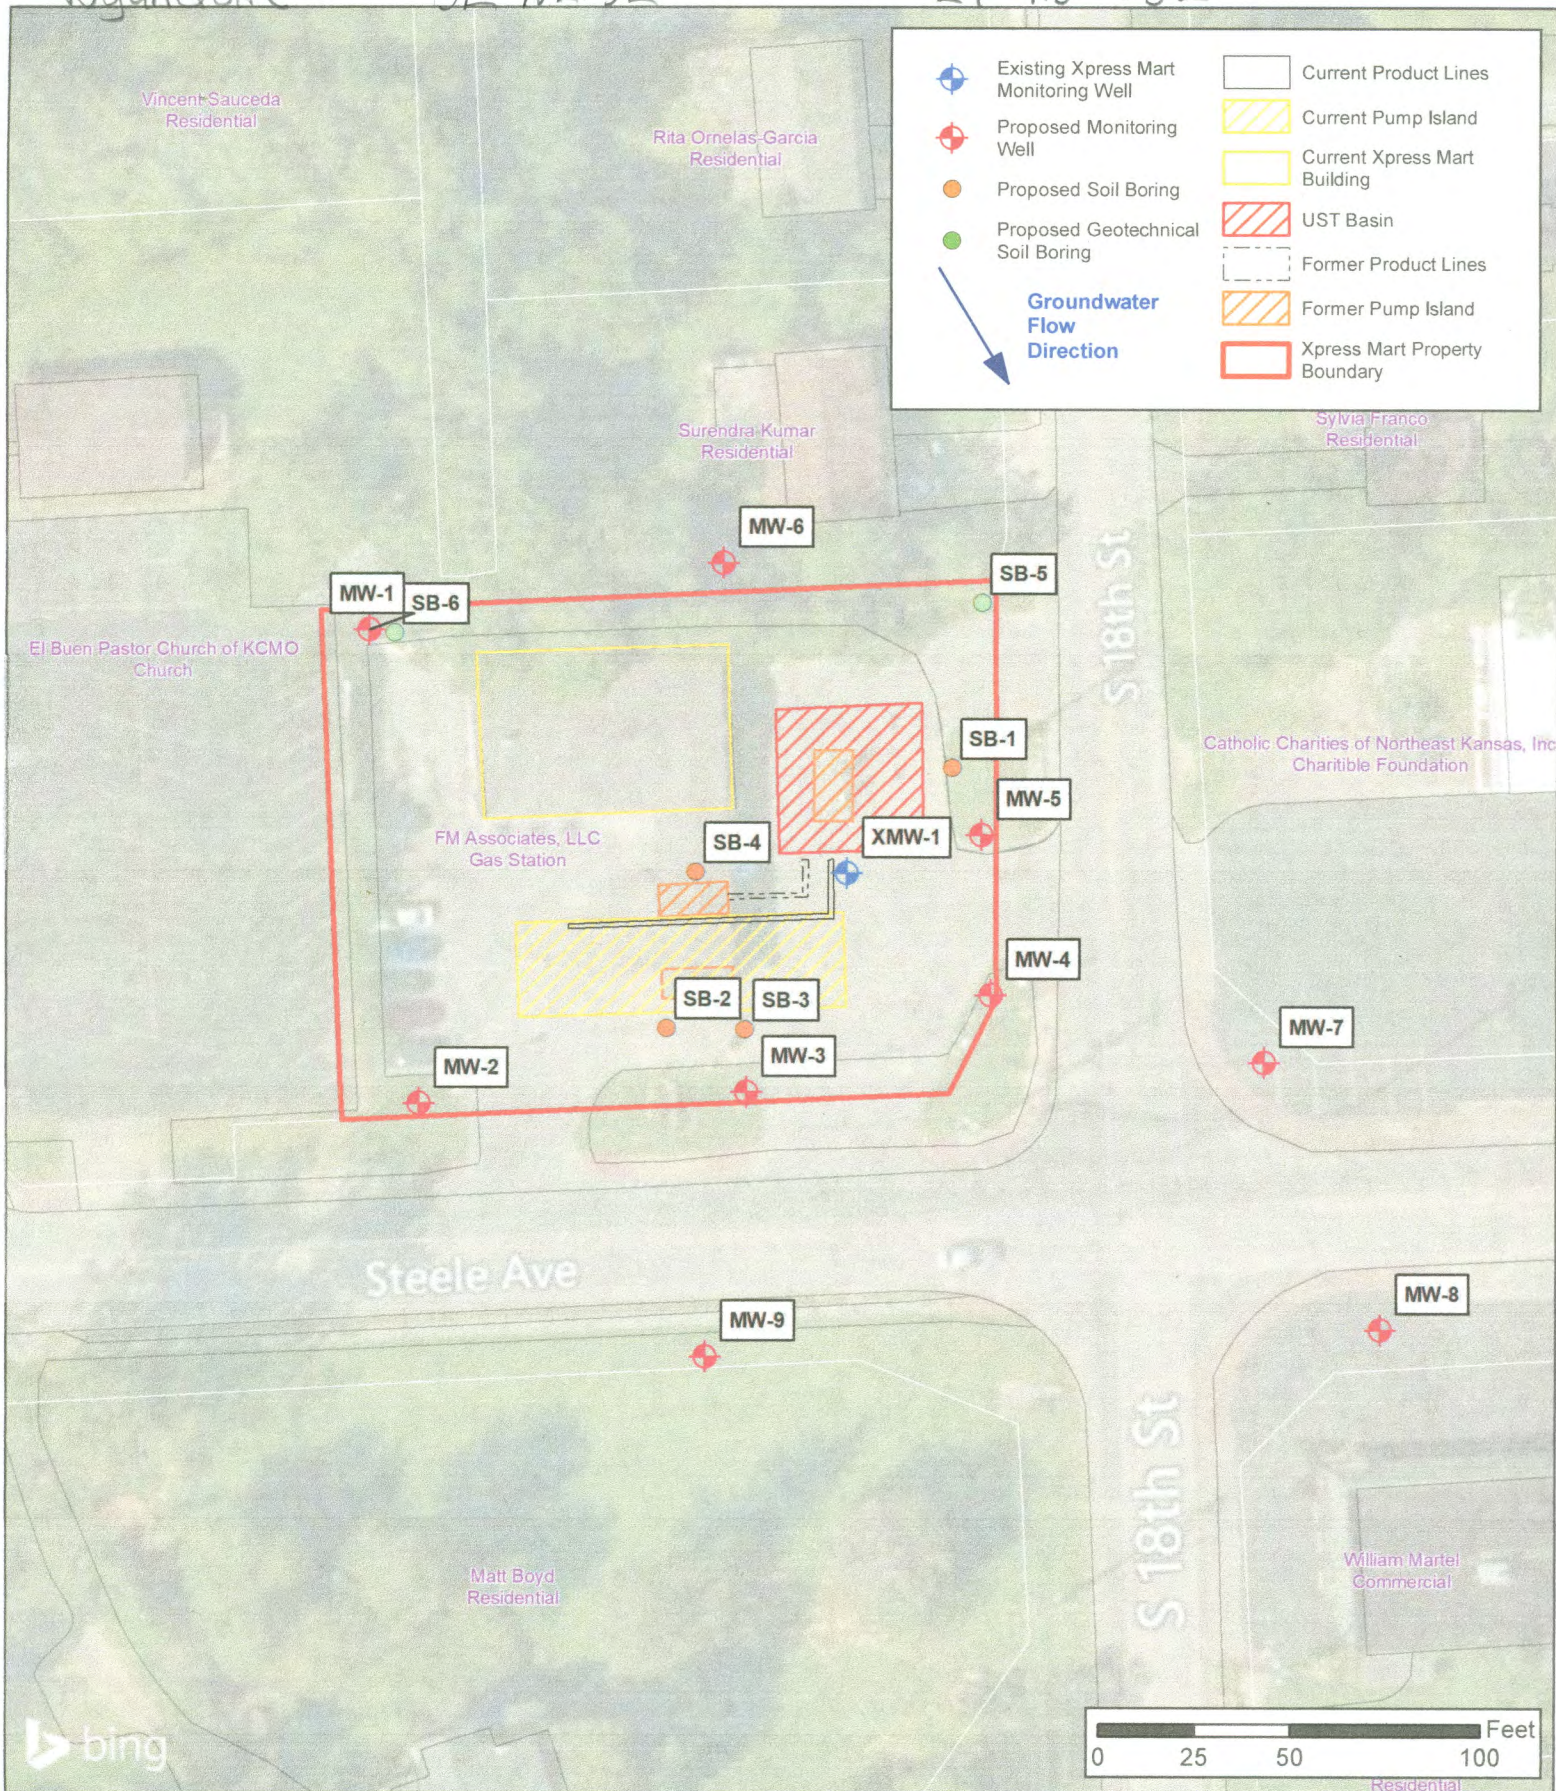

DESIGNED BY: CC		Detailed Site Map Xpress Mart		FIGURE 2	LSA Work Plan
DRAWN BY: CC					
CHECKED BY: RW		 professional practical below-ground	U4-105-14845 1800 Steele Road Kansas City, KS		
APPROVED BY: CC					
DATE: JUNE 2018					