


NOTE: Figures exhibited within this report are only to be used within the context of this report. Placement of property lines, wells, structures, and roads is based on the available information from county appraiser maps, surveys, site visits, and/or previous vendor reports and should be considered approximate.

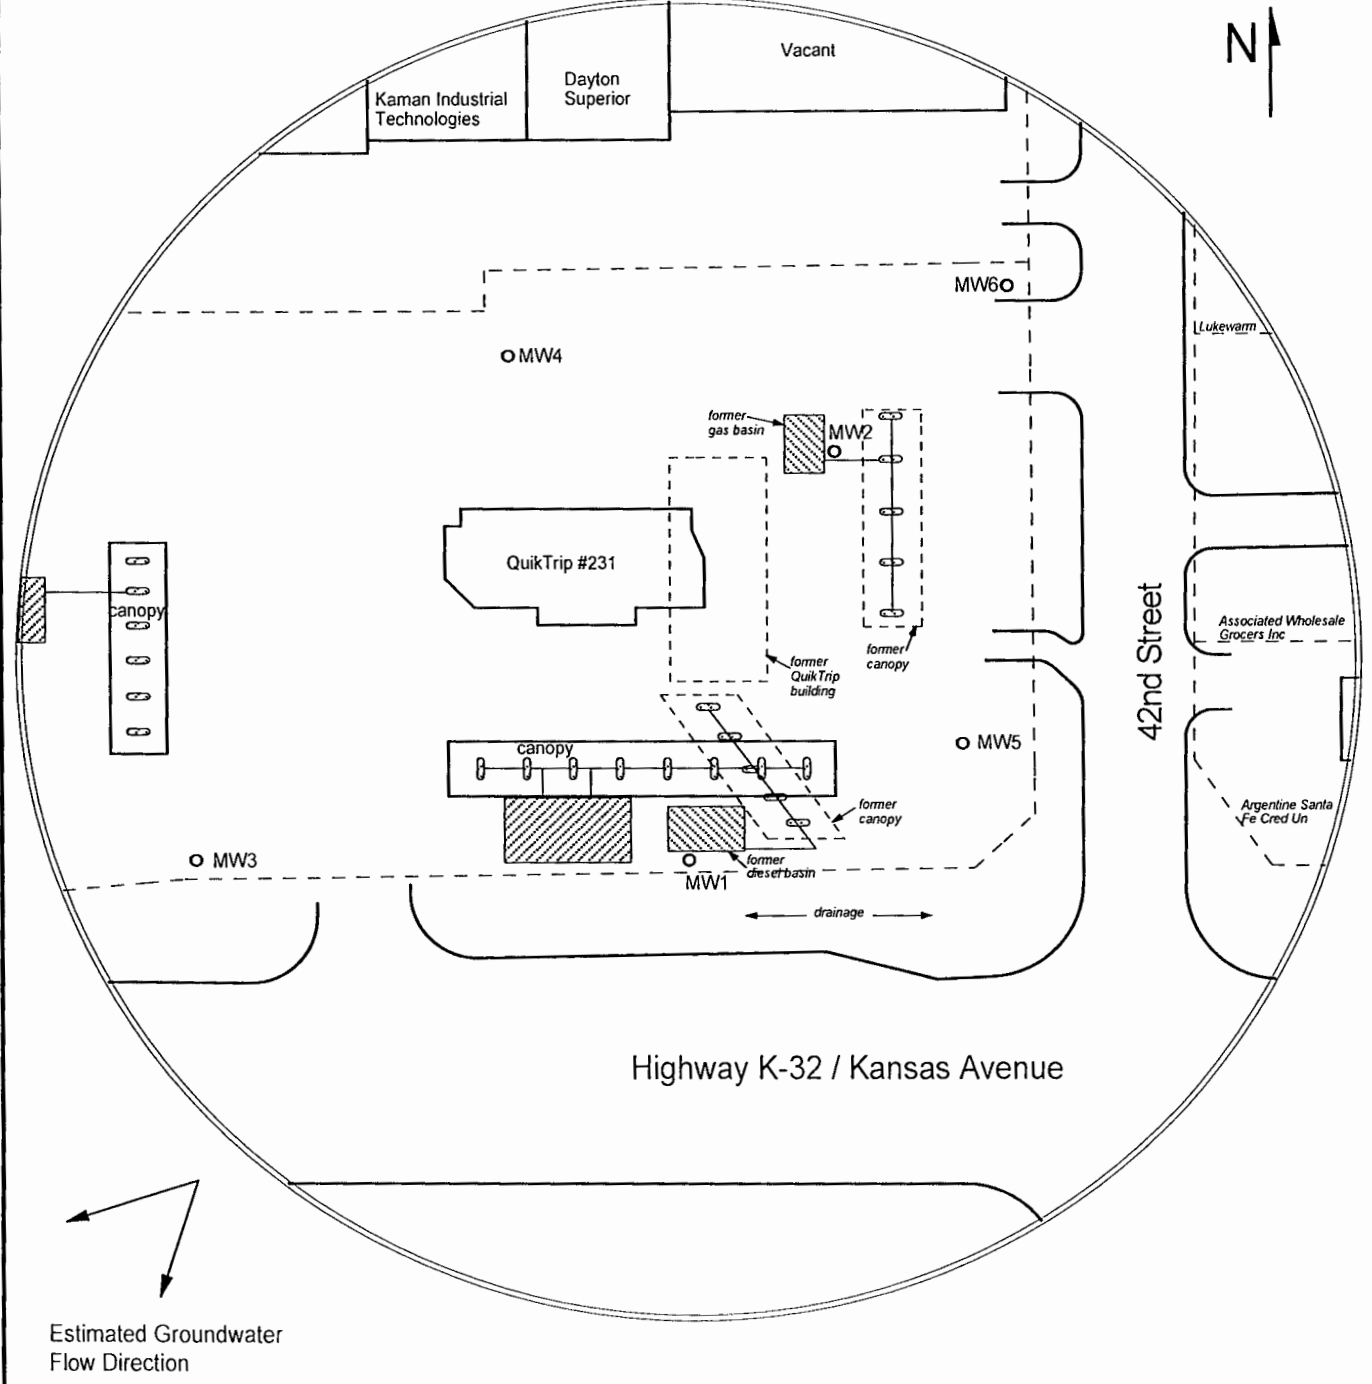


Estimated Groundwater Flow Direction

FIGURE 1 - 350 FT RADIUS AREA BASE MAP



PROJECT:
 Former QuikTrip #231
 4202 Kansas Avenue
 Kansas City, KS
 KDHE ID: U4-105-14927
 Date: 3/31/22

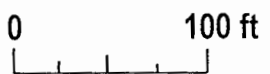

LEGEND:

- Approximate Location of Active UST Basin, Product Lines & Pump Islands
- Approximate Location of Former UST Basin, Product Lines & Pump Islands
- Approximate Location of Property Line
- Plugged Monitoring Well

RECEIVED

APR 15 2022

BUREAU OF WATER

1311 E 25th St. Suite B 785-841-8707 office
 Lawrence, KS 66046 785-865-4282 fax