


three copies to Kansas Department of Health and Environment, Division of Environment, Environmental Geology Section, Topeka, KS 66620. Send one to WATER WELL OWNER and retain one for your records.

R25E

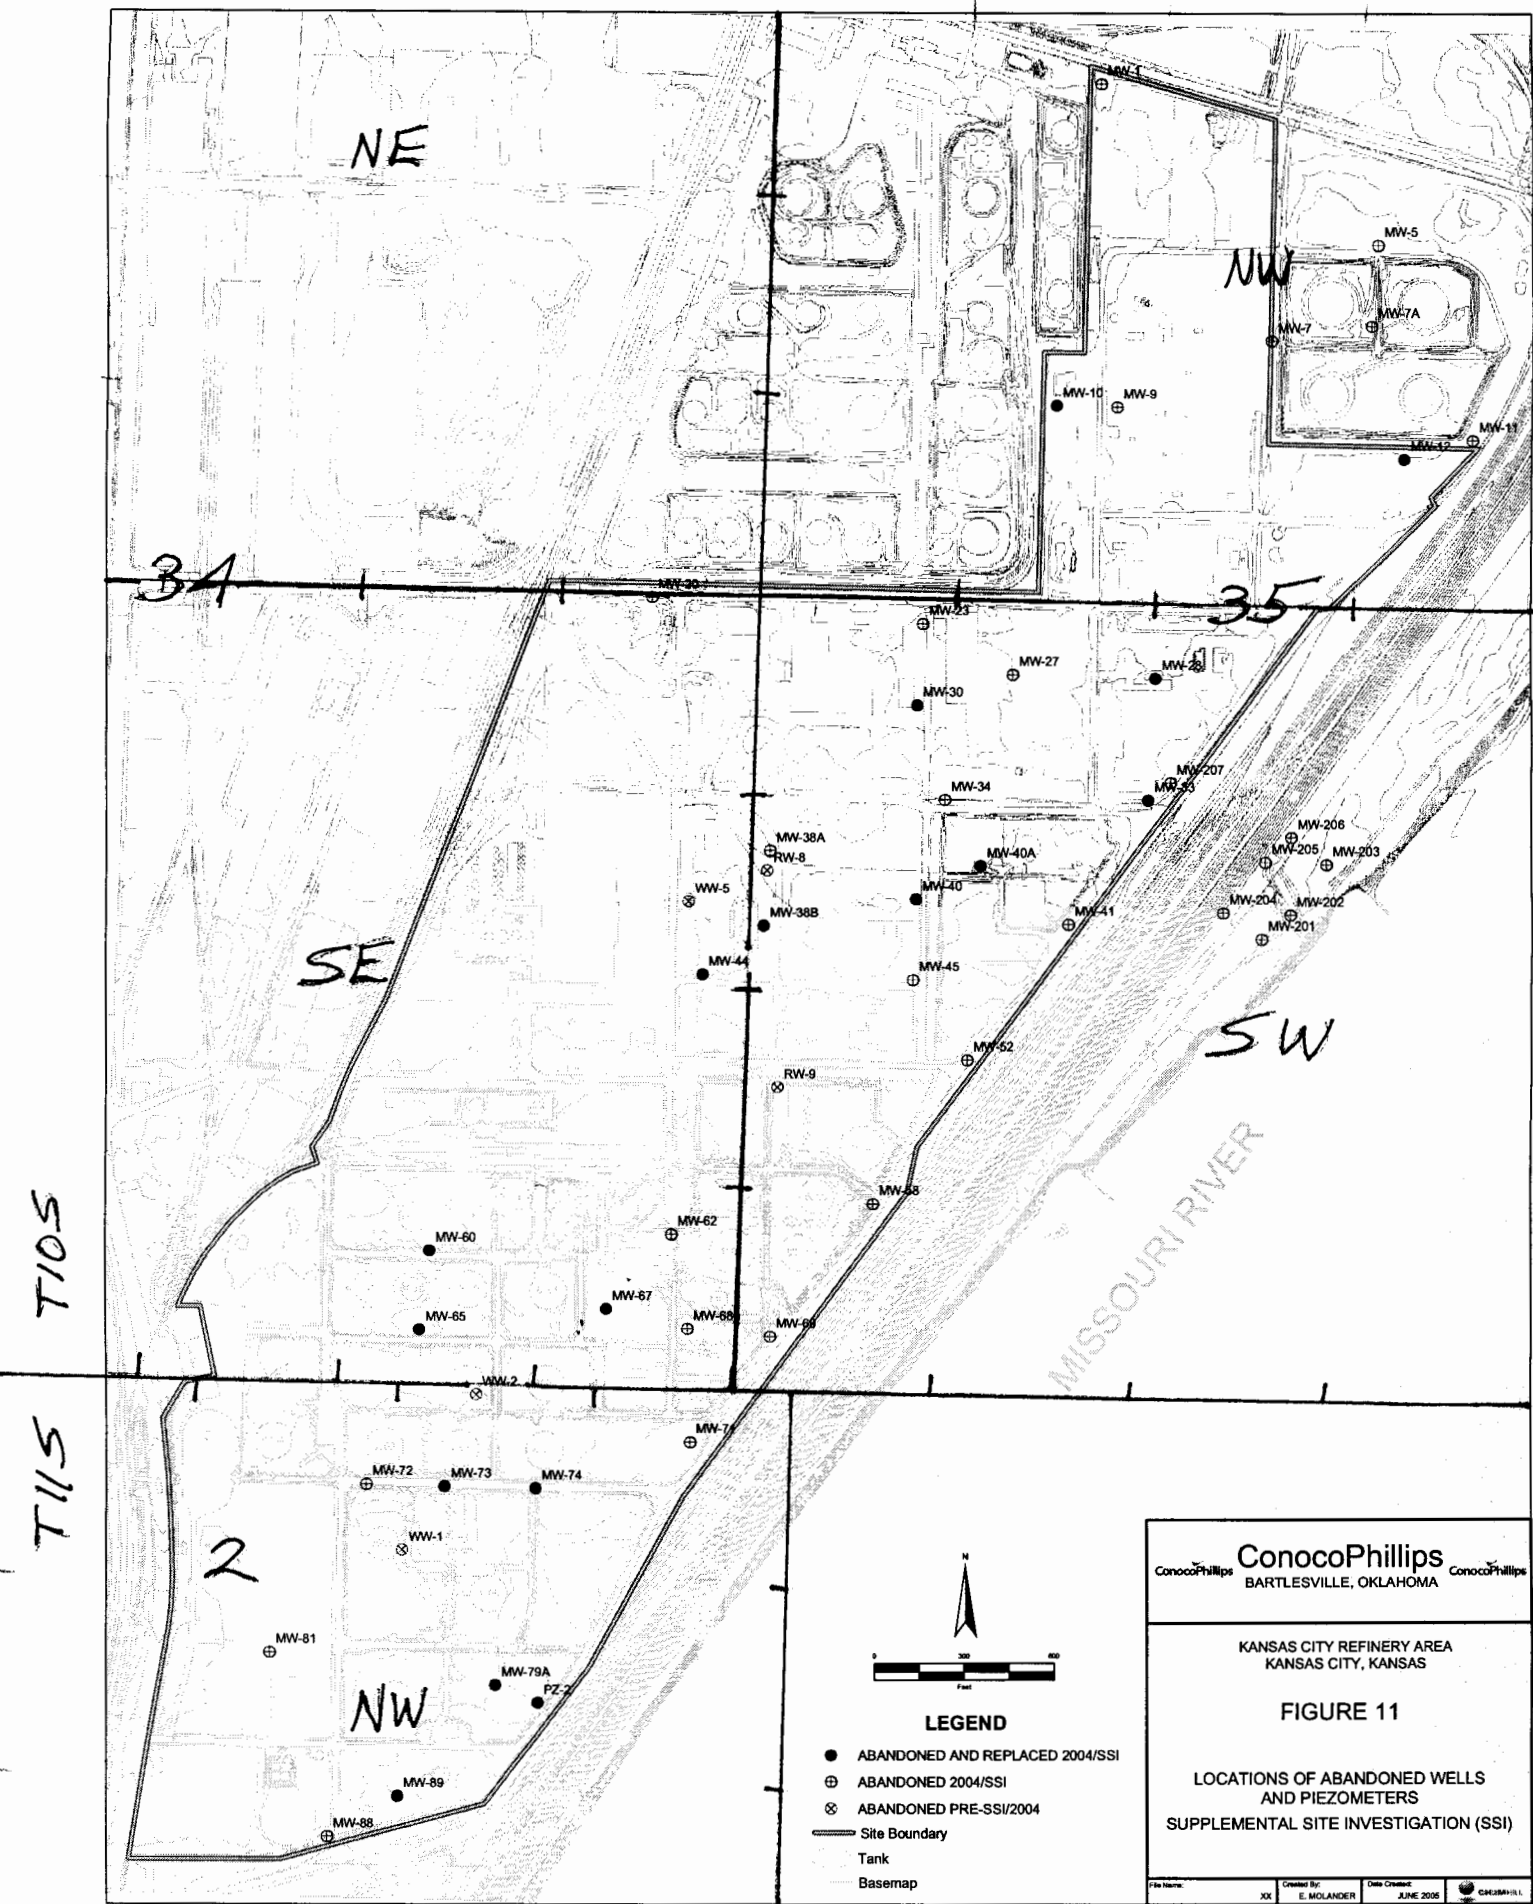

**ConocoPhillips**  
BARTLESVILLE, OKLAHOMA

KANSAS CITY REFINERY AREA  
KANSAS CITY, KANSAS

**FIGURE 11**

LOCATIONS OF ABANDONED WELLS  
AND PIEZOMETERS  
SUPPLEMENTAL SITE INVESTIGATION (SSI)

File Name:	Created By:	Date Created:	Checked By:
XX	E. MOLANDER	JUNE 2005	