MW-2

WATER WELL RECORD Form WWC-5 KSA 82a-1212

89C 7553 MW-2

1 LOCATION OF WATER WELL: County: Wyandotte | Fraction: NE¼ NE¼ NE¼ | Section Number: 3 | Township Number: T 11 S | Range Number: R 25 E/W

Distance and direction from nearest town or city street address of well if located within city? 900 ft ± 15° bearing from 1st & Walker K.C., KS

2 WATER WELL OWNER: Darby Corporation
RR#, St. Address, Box # : 1st & Walker
City, State, ZIP Code : K.C., KS

Board of Agriculture, Division of Water Resources
Application Number:

3 LOCATE WELL'S LOCATION WITH AN "X" IN SECTION BOX:

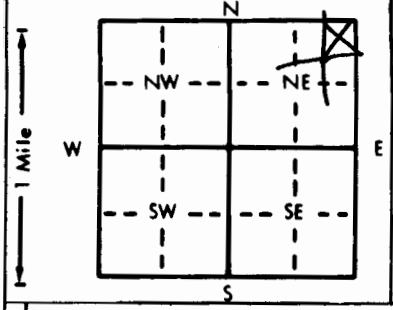

4 DEPTH OF COMPLETED WELL 30.0 ft. ELEVATION: 729.3
Depth(s) Groundwater Encountered 1. 13.0 ft. 2. ft. 3. ft.
WELL'S STATIC WATER LEVEL 3.78 ft. below land surface measured on mo/day/yr 7/24/89
Pump test data: Well water was ft. after hours pumping gpm
Est. Yield gpm: Well water was ft. after hours pumping gpm
Bore Hole Diameter 8" in. to 30.0 ft., and in. to ft.
WELL WATER TO BE USED AS: 1 Domestic 2 Irrigation 3 Feedlot 4 Industrial 5 Public water supply 6 Oil field water supply 7 Lawn and garden only 8 Air conditioning 9 Dewatering (10) Observation well 11 Injection well (12) Other (Specify below) monitoring well
Was a chemical/bacteriological sample submitted to Department? Yes (No); If yes, mo/day/yr sample was submitted
Water Well Disinfected? Yes (No)

5 TYPE OF BLANK CASING USED: 1 Steel (2) PVC 3 RMP (SR) 4 ABS 5 Wrought iron 6 Asbestos-Cement 7 Fiberglass 8 Concrete tile 9 Other (specify below)
CASING JOINTS: Glued Clamped Welded (Threaded)
Blank casing diameter 2 in. to 8.0 ft., Dia in. to ft., Dia in. to ft.
Casing height above land surface 2.0 in., weight 0.93 lbs./ft. Wall thickness or gauge No. 0.25"

TYPE OF SCREEN OR PERFORATION MATERIAL: 1 Steel 2 Brass 3 Stainless steel 4 Galvanized steel 5 Fiberglass 6 Concrete tile (7) PVC 8 RMP (SR) 9 ABS 10 Asbestos-cement 11 Other (specify) 12 None used (open hole)

SCREEN OR PERFORATION OPENINGS ARE: 1 Continuous slot (3) Mill slot 2 Louvered shutter 4 Key punched 5 Gauzed wrapped 6 Wire wrapped 7 Torch cut 8 Saw cut 9 Drilled holes 10 Other (specify) 11 None (open hole)

SCREEN-PERFORATED INTERVALS: From 8.0 ft. to 23.0 ft., From ft. to ft.
From ft. to ft., From ft. to ft.

GRAVEL PACK INTERVALS: From 6.0 ft. to 30.0 ft., From ft. to ft.
From ft. to ft., From ft. to ft.

6 GROUT MATERIAL: 1 Neat cement (2) Cement grout (3) Bentonite 4 Other
Grout Intervals: From 0 ft. to 4.0 ft., From 4.0 ft. to 6.0 ft., From ft. to ft.

What is the nearest source of possible contamination:
1 Septic tank 2 Sewer lines 3 Watertight sewer lines 4 Lateral lines 5 Cess pool 6 Seepage pit 7 Pit privy 8 Sewage lagoon 9 Feedyard 10 Livestock pens 11 Fuel storage 12 Fertilizer storage 13 Insecticide storage 14 Abandoned water well 15 Oil well/Gas well (16) Other (specify below) former refinery site
Direction from well? well drilled on former refinery site How many feet?

FROM	TO	LITHOLOGIC LOG	FROM	TO	LITHOLOGIC LOG
0	6	Sand, clay gravel fill			
6	8	Silty clay			
8	15	Clayey silt w/ wood fragments			
15	18	Lighter plastic clay			
18	22	Clayey silt w/ fine sand			
22	24	Silty clay			
24	28	Clayey silt			
28	30	Silty clay			

7 CONTRACTOR'S OR LANDOWNER'S CERTIFICATION: This water well was (1) constructed, (2) reconstructed, or (3) plugged under my jurisdiction and was completed on (mo/day/year) 7/12/89 and this record is true to the best of my knowledge and belief. Kansas Water Well Contractor's License No. 399 This Water Well Record was completed on (mo/day/yr) 10-17-89 under the business name of WOODWARD-CLYDE Consultants by (signature) Richard L. Mikesell

INSTRUCTIONS: Use typewriter or ball point pen. *PLEASE PRESS FIRMLY* and *PRINT* clearly. Please fill in blanks, underline or circle the correct answers. Send top three copies to Kansas Department of Health and Environment, Bureau of Water Protection, Topeka, Kansas 66620-7320, Telephone: 913-862-9360. Send one to WATER WELL OWNER and retain one for your records.

OFFICE USE ONLY T R E/W SEC. ¼ ¼ ¼