

1 LOCATION OF WATER WELL: County: <u>Wyandotte</u>	Fraction: <u>NE 1/4 NE 1/4 NE 1/4</u>	Section Number: <u>3</u>	Township Number: <u>T 11 S</u>	Range Number: <u>R 28 E</u>
---	---------------------------------------	--------------------------	--------------------------------	-----------------------------

Distance and direction from nearest town or city street address of well if located within city?

600 ft. 10° beam from 1st Walker K.C., KS2 WATER WELL OWNER: Dayby Corporation

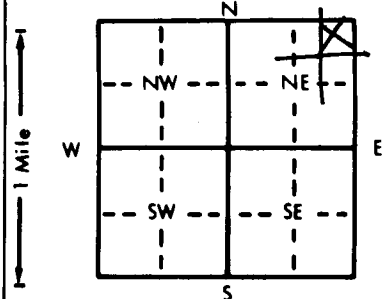
RR#, St. Address, Box # :

City, State, ZIP Code : 1st Walker K.C., KS.

Board of Agriculture, Division of Water Resources

Application Number:

3 LOCATE WELL'S LOCATION WITH AN "X" IN SECTION BOX:

4 DEPTH OF COMPLETED WELL: 27.0 ft. ELEVATION: 732.6Depth(s) Groundwater Encountered 1. 14.0 ft. 2. 14.0 ft. 3. 14.0 ft.WELL'S STATIC WATER LEVEL 3.35 ft. below land surface measured on mo/day/yr 7/24/09Pump test data: Well water was 14.

WELL WATER TO BE USED AS: 5 Public water supply 8 Air conditioning 11 Injection well

1 Domestic 3 Feedlot 6 Oil field water supply 9 Dewatering Other (Specify below)2 Irrigation 4 Industrial 7 Lawn and garden only 10 Observation well manhole wellWas a chemical/bacteriological sample submitted to Department? Yes No; If yes, mo/day/yr sample was submittedWater Well Disinfected? Yes No5 TYPE OF BLANK CASING USED: 5 Wrought iron 8 Concrete tile CASING JOINTS: Glued Clamped

1 Steel 3 RMP (SR) 6 Asbestos-Cement 9 Other (specify below) Welded

2 PVC 4 ABS 7 Fiberglass ThreadedBlank casing diameter 2 in. to 5.5 ft., Dia. 5.5 in. to 5.5 ft., Dia. 5.5 in. to 5.5 ft.Casing height above land surface 2.5 in., weight 0.93 lbs./ft. Wall thickness or gauge No. 0.25"TYPE OF SCREEN OR PERFORATION MATERIAL: 1 PVC 10 Asbestos-cement

1 Steel 3 Stainless steel 5 Fiberglass 8 RMP (SR) 11 Other (specify)

2 Brass 4 Galvanized steel 6 Concrete tile 9 ABS 12 None used (open hole)

SCREEN OR PERFORATION OPENINGS ARE: 5 Gauzed wrapped 8 Saw cut 11 None (open hole)

1 Continuous slot 3 Mill slot 6 Wire wrapped 9 Drilled holes

2 Louvered shutter 4 Key punched 7 Torch cut 10 Other (specify)

SCREEN-PERFORATED INTERVALS: From 5.5 ft. to 25.5 ft., From 5.5 ft. to 25.5 ft.From 5.5 ft. to 25.5 ft., From 5.5 ft. to 25.5 ft.GRAVEL PACK INTERVALS: From 4.0 ft. to 27.0 ft., From 4.0 ft. to 27.0 ft.From 4.0 ft. to 27.0 ft., From 4.0 ft. to 27.0 ft.6 GROUT MATERIAL: 1 Neat cement 2 Cement grout 3 Bentonite 4 OtherGrout intervals: From 0.25 ft. to 2.5 ft., From 2.5 ft. to 4.0 ft., From 4.0 ft. to 4.0 ft.

What is the nearest source of possible contamination: 10 Livestock pens 14 Abandoned water well

1 Septic tank 4 Lateral lines 7 Pit privy 11 Fuel storage 15 Oil well/Gas well

2 Sewer lines 5 Cess pool 8 Sewage lagoon 12 Fertilizer storage 16 Other (specify below)3 Watertight sewer lines 6 Seepage pit 9 Feedyard 13 Insecticide storage former refinery siteDirection from well? well drilled on former refinery site How many feet?

FROM TO LITHOLOGIC LOG FROM TO LITHOLOGIC LOG

0 2.5 sandy-gravel fill2.5 20.0 silty clay20.0 23.0 clayey silt w/ fine sand23.0 24.0 low plastic silty clay24.0 27.0 clayey silt w/ fine sand7 CONTRACTOR'S OR LANDOWNER'S CERTIFICATION: This water well was 1 constructed, (2) reconstructed, or (3) plugged under my jurisdiction and wascompleted on (mo/day/year) 7/11/09 and this record is true to the best of my knowledge and belief. KansasWater Well Contractor's License No. 399 This Water Well Record was completed on (mo/day/yr) 10-17-09under the business name of WOODWARD-CLYDE CONSULTANTS by (signature) Richard A. Woodward

INSTRUCTIONS: Use typewriter or ball point pen. PLEASE PRESS FIRMLY and PRINT clearly. Please fill in blanks, underline or circle the correct answers. Send top three copies to Kansas

Department of Health and Environment, Bureau of Water Protection, Topeka, Kansas 66620-7320, Telephone: 913-862-9360. Send one to WATER WELL OWNER and retain one for your

records.